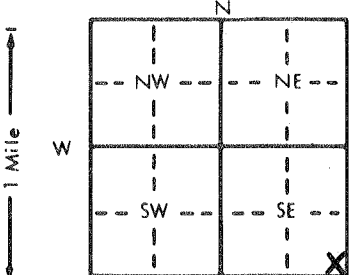


| | | | | |
|---------------------------|----------------------|----------------|-----------------|--------------|
| 1 LOCATION OF WATER WELL: | Fraction | Section Number | Township Number | Range Number |
| County: Rush | SE 1/4 SE 1/4 SE 1/4 | 33 | T 17 S | R 17 E |

Distance and direction from nearest town or city street address of well if located within city?

101 North Main, Bison, Kansas MW#3

| | | |
|---------------------------|----------------|---|
| 2 WATER WELL OWNER: | Mid-State Coop | Board of Agriculture, Division of Water Resources |
| RR#, St. Address, Box # : | 101 North Main | Application Number: |
| City, State, ZIP Code : | Bison, Kansas | |

| | |
|--|---|
| 3 LOCATE WELL'S LOCATION WITH AN "X" IN SECTION BOX: | 4 DEPTH OF COMPLETED WELL... 51.5 ft. ELEVATION: |
|  | Depth(s) Groundwater Encountered 1. 46.00 ft. 2. ft. 3. ft. |
| | WELL'S STATIC WATER LEVEL 43 ft. below land surface measured on mo/day/yr 12-11-92 |
| | Pump test data: Well water was ft. after hours pumping gpm |
| | Est. Yield gpm: Well water was ft. after hours pumping gpm |
| | Bore Hole Diameter 7. 7/8 in. to 51.5 ft., and in. to ft. |
| | WELL WATER TO BE USED AS: 5 Public water supply 8 Air conditioning 11 Injection well |
| | 1 Domestic 3 Feedlot 6 Oil field water supply 9 Dewatering 12 Other (Specify below) |
| | 2 Irrigation 4 Industrial 7 Lawn and garden only 10 Monitoring well |
| | Was a chemical/bacteriological sample submitted to Department? Yes No; If yes, mo/day/yr sample was submitted |
| | Water Well Disinfected? Yes No |

| | | | |
|---|--------------------|-------------------|------------------------------|
| 5 TYPE OF BLANK CASING USED: | 5 Wrought iron | 8 Concrete tile | CASING JOINTS: Glued Clamped |
| 1 Steel | 3 RMP (SR) | 6 Asbestos-Cement | 9 Other (specify below) |
| 2 PVC | 4 ABS | 7 Fiberglass | 10 Asbestos-cement |
| Blank casing diameter 2 in. to 31.5 ft., Dia | | | 11 Other (specify) |
| Casing height above land surface 27 in., weight | | | 12 None used (open hole) |
| TYPE OF SCREEN OR PERFORATION MATERIAL: | | | |
| 1 Steel | 3 Stainless steel | 5 Fiberglass | 8 RMP (SR) |
| 2 Brass | 4 Galvanized steel | 6 Concrete tile | 9 ABS |
| SCREEN OR PERFORATION OPENINGS ARE: | | | |
| 1 Continuous slot | 2 Mill slot | 3 Gauzed wrapped | 8 Saw cut |
| 2 Louvered shutter | 4 Key punched | 6 Wire wrapped | 9 Drilled holes |
| | | 7 Torch cut | 10 Other (specify) |
| SCREEN-PERFORATED INTERVALS: | | | |
| From 31.5 ft. to 51.5 ft. | | | |
| GRAVEL PACK INTERVALS: | | | |
| From 30.0 ft. to 51.5 ft. | | | |

| | | | | |
|---|-----------------|-----------------|-----------------------|--------------------------|
| 6 GROUT MATERIAL: | 1 Neat cement | 2 Cement grout | 3 Bentonite | 4 Other |
| Grout Intervals: From 0 ft. to 28 ft. | | | | |
| What is the nearest source of possible contamination: | | | | |
| 1 Septic tank | 4 Lateral lines | 7 Pit privy | 10 Livestock pens | 14 Abandoned water well |
| 2 Sewer lines | 5 Cess pool | 8 Sewage lagoon | 11 Fuel storage | 15 Oil well/Gas well |
| 3 Watertight sewer lines | 6 Seepage pit | 9 Feedyard | 12 Fertilizer storage | 16 Other (specify below) |
| Direction from well? south and east | | | | |
| | | | How many feet? 60 | |

| FROM | TO | LITHOLOGIC LOG | FROM | TO | PLUGGING INTERVALS |
|------|------|--|------|----|--------------------|
| 0 | 5 | dark brown clay | | | |
| 5 | 15 | medium brown clay silty | | | |
| 15 | 20 | red brown clay, very silty | | | |
| 20 | 27 | medium brown clay, silty | | | |
| 27 | 35 | red brown clay, very silty | | | |
| 35 | 45 | medium light brown clay, silty | | | |
| 45 | 51.5 | brown clay and sand - coarse to medium grained | | | |

| |
|---|
| 7 CONTRACTOR'S OR LANDOWNER'S CERTIFICATION: This water well was (1) constructed, (2) reconstructed, or (3) plugged under my jurisdiction and was completed on (mo/day/year) 10-16-92 and this record is true to the best of my knowledge and belief. Kansas Water Well Contractor's License No. 527 This Water Well Record was completed on (mo/day/yr) 12-28-92 under the business name of GeoCore Services, Inc. by (signature) Doug Ray |
|---|