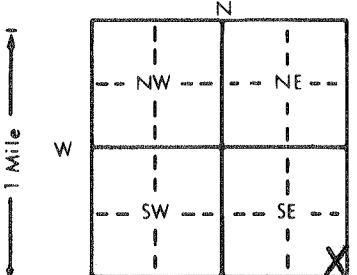


1 LOCATION OF WATER WELL:	Fraction	Section Number	Township Number	Range Number
County: Rush	SE 1/4 SE 1/4 SE 1/4	33	T 17 S	R 17 E

Distance and direction from nearest town or city street address of well if located within city?

101 North Main, Bison, Kansas MW#5

2 WATER WELL OWNER:	Mid-State Coop	Board of Agriculture, Division of Water Resources
RR#, St. Address, Box # :	101 North Main	Application Number:
City, State, ZIP Code :	Bison, Kansas	

3 LOCATE WELL'S LOCATION WITH AN "X" IN SECTION BOX:	4 DEPTH OF COMPLETED WELL: 59 ft. ELEVATION:
	Depth(s) Groundwater Encountered 1. 45 ft. 2. ft. 3. ft.
	WELL'S STATIC WATER LEVEL 44 ft. below land surface measured on mo/day/yr 12-11-92
	Pump test data: Well water was ft. after hours pumping gpm
	Est. Yield gpm: Well water was ft. after hours pumping gpm
	Bore Hole Diameter 7 7/8 in. to 59 ft. and in. to ft.
	WELL WATER TO BE USED AS:
	1 Domestic 3 Feedlot 6 Oil field water supply 9 Dewatering 12 Other (Specify below)
	2 Irrigation 4 Industrial 7 Lawn and garden only 10 Monitoring well
	Was a chemical/bacteriological sample submitted to Department? Yes No If yes, mo/day/yr sample was submitted
	Water Well Disinfected? Yes No

5 TYPE OF BLANK CASING USED:	5 Wrought iron	8 Concrete tile	CASING JOINTS: Glued Clamped
1 Steel	3 RMP (SR)	6 Asbestos-Cement	9 Other (specify below)
2 PVC	4 ABS	7 Fiberglass	Welded Threaded
Blank casing diameter 2 in. to 39 ft. Dia			
Casing height above land surface in. weight lbs./ft. Wall thickness or gauge No. Sch 40			
TYPE OF SCREEN OR PERFORATION MATERIAL:	5 Wrought iron	8 Concrete tile	10 Asbestos-cement
1 Steel	3 Stainless steel	5 Fiberglass	8 RMP (SR)
2 Brass	4 Galvanized steel	6 Concrete tile	9 ABS
SCREEN OR PERFORATION OPENINGS ARE:	5 Gauzed wrapped	8 Saw cut	11 None (open hole)
1 Continuous slot	3 Mill slot	6 Wire wrapped	9 Drilled holes
2 Louvered shutter	4 Key punched	7 Torch cut	10 Other (specify)
SCREEN-PERFORATED INTERVALS:	From 39 ft. to 59 ft.		
GRAVEL PACK INTERVALS:	From 37 ft. to 59 ft.		

6 GROUT MATERIAL:	1 Neat cement	2 Cement grout	3 Bentonite	4 Other
Grout Intervals: From 0 ft. to 35 ft. From 35 ft. to 37 ft. From 37 ft. to ft.				
What is the nearest source of possible contamination:	10 Livestock pens	14 Abandoned water well		
1 Septic tank	4 Lateral lines	7 Pit privy	11 Fuel storage	15 Oil well/Gas well
2 Sewer lines	5 Cess pool	8 Sewage lagoon	12 Fertilizer storage	16 Other (specify below)
3 Watertight sewer lines	6 Seepage pit	9 Feedyard	13 Insecticide storage	
Direction from well? northeast			How many feet? 140	

FROM	TO	LITHOLOGIC LOG	FROM	TO	PLUGGING INTERVALS
0	7	dark brown clay			
7	12	medium brown clay, silty			flush mount cover
12	17	red brown clay, silty			
17	27	medium brown clay very silty			KDHE ID # 00092627
27	32	red brown clay, silty			
32	45	medium brown clay, very silty			
45	59	medium brown clay, sand stringers			

7 CONTRACTOR'S OR LANDOWNER'S CERTIFICATION: This water well was (1) constructed, (2) reconstructed, or (3) plugged under my jurisdiction and was completed on (mo/day/year) 10-16-92 and this record is true to the best of my knowledge and belief. Kansas Water Well Contractor's License No. 527 This Water Well Record was completed on (mo/day/yr) 12-28-92 under the business name of GeoCore Services, Inc. by (signature) Davey Ray
--