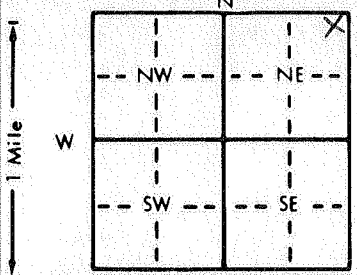


1 LOCATION OF WATER WELL: County: <u>RUSH</u>	Fraction <u>NE 1/4 NE 1/4 NE 1/4</u>	Section Number <u>33</u>	Township Number T <u>17</u> S	Range Number R <u>18</u> EW
--	---	-----------------------------	----------------------------------	--------------------------------

Distance and direction from nearest town or city street address of well if located within city?

150 FEET SOUTH & 250 FEET WEST OF INTERSECTION HIGHWAYS K-4 & US-183

2 WATER WELL OWNER: <u>MS. SHELLY DELKERS</u> RR#, St. Address, Box #: <u>RR1, BOX 2</u> City, State, ZIP Code: <u>LA CROSSE, KS 67548</u>	MW-9 Board of Agriculture, Division of Water Resources Application Number:
--	--

chemical/bacteriological sample submitted to Department? Yes <u>No</u> ; If yes, mo/day/yr sample was submitted Water Well Disinfected? Yes <u>No</u>
--	---


--	---

How many feet? <u>350</u>

FROM	TO	LITHOLOGIC LOG	FROM	TO	PLUGGING INTERVALS
<u>0</u>	<u>1.5</u>	<u>SILTY CLAY, DARK BROWN, FIRM</u>			
<u>1.5</u>	<u>4.5</u>	<u>SILTY CLAY, LIGHT RED, FIRM</u>			
<u>4.5</u>	<u>11</u>	<u>SILTY CLAY, RED BROWN, STIFF</u>			
<u>11</u>	<u>15.5</u>	<u>SILTY CLAY, YELLOW BROWN, SHALY</u>			
<u>15.5</u>	<u>18</u>	<u>SHALE, YELLOW BROWN, LIMY</u>			
<u>18</u>	<u>21</u>	<u>SHALE, AS ABOVE BUT SATURATED</u>			

7 CONTRACTOR'S OR LANDOWNER'S CERTIFICATION: This water well was (1) <u>constructed</u> , (2) reconstructed, or (3) plugged under my jurisdiction and was completed on (mo/day/year) <u>12/3/96</u> and this record is true to the best of my knowledge and belief. Kansas Water Well Contractor's License No. <u>524</u> This Water Well Record was completed on (mo/day/yr) <u>12/9/96</u> under the business name of <u>ALLIED LABORATORIES</u> by (signature) <u>[Signature]</u>
--