


1 LOCATION OF WATER WELL: Fraction NE 1/4 NE 1/4 NE 1/4 Section Number 33 Township Number T 17 S Range Number R 18 EW
 County: RUSH

Distance and direction from nearest town or city street address of well if located within city?
200 FEET SOUTH & 130 FEET WEST OF INTERSECTION HIGHWAYS K-4 & US-183

2 WATER WELL OWNER: MS. SHELLY DELKERS MW-10
 RR#, St. Address, Box #: RR1, Box 2 Board of Agriculture, Division of Water Resources
 City, State, ZIP Code: LA CROSSE, KS 67548 Application Number:

3 LOCATE WELL'S LOCATION WITH AN "X" IN SECTION BOX:

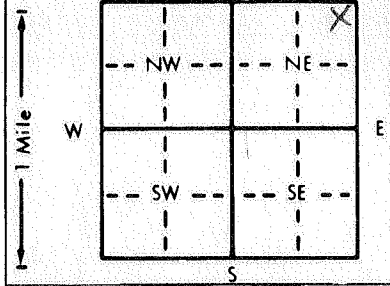

4 DEPTH OF COMPLETED WELL: 21 ft. ELEVATION:
 Depth(s) Groundwater Encountered 1. 18 ft. 2. ft. 3. ft.
 WELL'S STATIC WATER LEVEL: 13.83 ft. below land surface measured on mo/day/yr 12/15/96
 Pump test data: Well water was ft. after hours pumping gpm
 Est. Yield gpm: Well water was ft. after hours pumping gpm
 Bore Hole Diameter: 8 in. to 21 ft., and in. to ft.
 WELL WATER TO BE USED AS:
 5 Public water supply 8 Air conditioning 11 Injection well
 1 Domestic 3 Feedlot 6 Oil field water supply 9 Dewatering 12 Other (Specify below)
 2 Irrigation 4 Industrial 7 Lawn and garden only 10 Monitoring well
 Was a chemical/bacteriological sample submitted to Department? Yes No; If yes, mo/day/yr sample was submitted
 Water Well Disinfected? Yes No

5 TYPE OF BLANK CASING USED:
 1 Steel 3 RMP (SR) 5 Wrought iron 8 Concrete tile CASING JOINTS: Glued Clamped
2 PVC 4 ABS 7 Fiberglass 9 Other (specify below) Welded
Threaded

Blank casing diameter: 2 in. to 11 ft., Dia. in. to ft., Dia. in. to ft.
 Casing height above land surface: 0 in., weight lbs./ft. Wall thickness or gauge No. Schedule 40

TYPE OF SCREEN OR PERFORATION MATERIAL:
 1 Steel 3 Stainless steel 5 Fiberglass 8 RMP (SR) 10 Asbestos-cement
 2 Brass 4 Galvanized steel 6 Concrete tile 9 ABS 11 Other (specify)
 12 None used (open hole)

SCREEN OR PERFORATION OPENINGS ARE:
 1 Continuous slot 3 Mill slot 5 Gauzed wrapped 8 Saw cut 11 None (open hole)
 2 Louvered shutter 4 Key punched 6 Wire wrapped 9 Drilled holes
 7 Torch cut 10 Other (specify)

SCREEN-PERFORATED INTERVALS: From 11 ft. to 21 ft., From ft. to ft.
 From ft. to ft., From ft. to ft.
 GRAVEL PACK INTERVALS: From 9 ft. to 21 ft., From ft. to ft.
 From ft. to ft., From ft. to ft.

6 GROUT MATERIAL: 1 Neat cement 2 Cement grout 3 Bentonite 4 Other
 Grout Intervals: From 1 ft. to 97 ft., From ft. to ft., From ft. to ft.

What is the nearest source of possible contamination:
 1 Septic tank 4 Lateral lines 7 Pit privy 10 Livestock pens 14 Abandoned water well
 2 Sewer lines 5 Cess pool 8 Sewage lagoon 11 Fuel storage 15 Oil well/Gas well
 3 Watertight sewer lines 6 Seepage pit 9 Feedyard 12 Fertilizer storage 16 Other (specify below)
 13 Insecticide storage
 Direction from well? NORTH How many feet? 350

FROM	TO	LITHOLOGIC LOG	FROM	TO	PLUGGING INTERVALS
0	3	SILTY CLAY, DARK BROWN, FIRM			
3	7	SILTY CLAY, RED BROWN, STIFF			
7	10	SILTY CLAY, RED BROWN, MOIST			
10	15.5	SILTY CLAY, YELLOW BROWN, SHALY			
15.5	20	SHALE, YELLOW BROWN, LIMY			
20	21	SHALE, SATURATED, w/LIMESTONE			

7 CONTRACTOR'S OR LANDOWNER'S CERTIFICATION: This water well was (1) constructed, (2) reconstructed, or (3) plugged under my jurisdiction and was completed on (mo/day/year) 12/15/96 and this record is true to the best of my knowledge and belief. Kansas Water Well Contractor's License No. 524 This Water Well Record was completed on (mo/day/yr) 12/15/96 under the business name of ALLIED LABORATORIES by (signature) [Signature]