


1 LOCATION OF WATER WELL: Fraction SW 1/4 SW 1/4 NW 1/4 Section Number 34 Township Number T 17 S Range Number R 18 **EW**

Distance and direction from nearest town or city street address of well if located within city?  
**1022 Main Street, LaCrosse, Kansas**

2 WATER WELL OWNER: **Schaffer Oil Company**  
 RR#, St. Address, Box # : **Box 538** Board of Agriculture, Division of Water Resources  
 City, State, ZIP Code : **LaCrosse, Kansas 67548** Application Number:

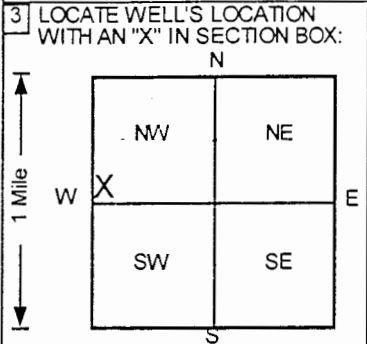

4 DEPTH OF COMPLETED WELL: 19 ft ELEVATION: 2061.15  
 Depth(s) Groundwater Encountered 1. 999 ft 2. ft 3. ft  
 WELL'S STATIC WATER LEVEL: 11.74 ft below land surface measured on mo/day/yr 9/4/97  
 Pump test data: Well water was NA ft after hours pumping gpm  
 Est. Yield NA gpm: Well water was ft after hours pumping gpm  
 Bore Hole Diameter 8 in. to 19 ft, and in. to ft  
 WELL WATER TO BE USED AS: 5 Public water supply 8 Air conditioning 11 Injection well  
 1 Domestic 3 Feedlot 6 Oil field water supply 9 Dewatering 12 Other (Specify below)  
 2 Irrigation 4 Industrial 7 Lawn and garden only 10 Monitoring well  
 Was a chemical/bacteriological sample submitted to Department? Yes No  If yes, mo/day/yr sample was submitted  
 Water Well Disinfected? Yes No

5 TYPE OF BLANK CASING USED: 5 Wrought iron 8 Concrete tile CASING JOINTS: Glued Clamped  
 1 Steel 3 RMP (SR) 6 Asbestos-Cement 9 Other (specify below) Welded  
 2 PVC 4 ABS 7 Fiberglass Threaded   
 Blank casing diameter 2 in. to 9 ft, Dia in. to ft, Dia in. to ft  
 Casing height above land surface -6.96 in., weight Sch 40 lbs./ft. Wall thickness or gauge No.  
 TYPE OF SCREEN OR PERFORATION MATERIAL 7 PVC 10 Asbestos-cement  
 1 Steel 3 Stainless steel 5 Fiberglass 8 RMP (SR) 11 Other (specify)  
 2 Brass 4 Galvanized steel 6 Concrete tile 9 ABS 12 None used (open hole)  
 SCREEN OR PERFORATION OPENINGS ARE: 5 Gauzed wrapped 8 Saw cut 11 None (open hole)  
 1 Continuous slot 3 Mill slot 6 Wire wrapped 9 Drilled holes  
 2 Louvered shutter 4 Key punched 7 Torch cut 10 Other (specify)  
 SCREEN-PERFORATED INTERVALS: From 9 ft to 19 ft, From ft to ft  
 GRAVEL PACK INTERVALS: From 8 ft to 19 ft, From ft to ft

6 GROUT MATERIAL: 1 Neat cement 2 Cement grout 3 Bentonite 4 Other  
 Grout Intervals: From 0 ft to 6 ft, From 6 ft to 8 ft, From ft to ft  
 What is the nearest source of possible contamination: 10 Livestock pens 14 Abandoned water well  
 1 Septic tank 4 Lateral lines 7 Pit privy 11 Fuel storage 15 Oil well/Gas well  
 2 Sewer lines 5 Cess pool 8 Sewage lagoon 12 Fertilizer storage 16 Other (specify below)  
 3 Watertight sewer lines 6 Seepage pit 9 Feedyard 13 Insecticide storage Former Tank Basin  
 Direction from well? North How many feet? 110

FROM	TO	LITHOLOGIC LOG	FROM	TO	PLUGGING INTERVALS
0	1	Sand/Gravel,			
1	5	Clay, Dark Brown			
5	8	Clay, Red Brown			
8	11	Clay, Light Red Brown			
11	19	Clay, Light Gray Brown			
					MW4, Tag # 00192657, Flushmount
					Project Name: Schaffer Oil Company
					GeoCore # 486, KDHE # U6 083 10617

7 CONTRACTOR'S OR LANDOWNER'S CERTIFICATION: This water well was (1) constructed, (2) reconstructed, or (3) plugged under my jurisdiction and was completed on (mo/day/year) 9/2/97 and this record is true to the best of my knowledge and belief.  
 Kansas Water Well Contractor's License No. 527 This Water Well Record was completed on (mo/day/yr) 9/26/97 under the business name of **GeoCore Services, Inc.** by (signature) *Dale Hill*

INSTRUCTIONS: Use typewriter or ball point pen. PLEASE PRESS FIRMLY and PRINT clearly. Please fill in blanks, underline or circle the correct answers. Send top three copies to Kansas Department of Health and Environment, Bureau of Water, Topeka, Kansas 66620-0001. Telephone: 913-296-5545. Send one to WATER WELL OWNER and retain one for your records.