


1 LOCATION OF WATER WELL: County: Rush Fraction NW 1/4 SW 1/4 NW 1/4 Section Number 34 Township Number T 17 S Range Number R 18 EW

Distance and direction from nearest town or city street address of well if located within city? 1022 Main Street, LaCrosse, Kansas

2 WATER WELL OWNER: Schaffer Oil Company RR#, St. Address, Box #: Box 538 City, State, ZIP Code: LaCrosse, Kansas 67548 Board of Agriculture, Division of Water Resources Application Number:

3 LOCATE WELL'S LOCATION WITH AN "X" IN SECTION BOX:

4 DEPTH OF COMPLETED WELL: 19 ft ELEVATION: 2060.02

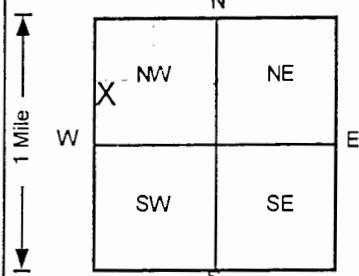

Depth(s) Groundwater Encountered 1. 10.46 ft 2. ft 3. ft WELL'S STATIC WATER LEVEL ... ft below land surface measured on mo/day/yr Pump test data: Well water was NA ft after ... hours pumping ... gpm Est. Yield NA gpm: Well water was ... ft after ... hours pumping ... gpm Bore Hole Diameter ... 8 ... in. to ... 19 ... ft, and ... in. to ... ft WELL WATER TO BE USED AS: 5 Public water supply 8 Air conditioning 11 Injection well 1 Domestic 3 Feedlot 6 Oil field water supply 9 Dewatering 12 Other (Specify below) 2 Irrigation 4 Industrial 7 Lawn and garden only 10 Monitoring well Was a chemical/bacteriological sample submitted to Department? Yes No; If yes, mo/day/yr sample was submitted Water Well Disinfected? Yes No

5 TYPE OF BLANK CASING USED: 1 Steel 2 PVC 3 RMP (SR) 4 ABS 5 Wrought iron 6 Asbestos-Cement 7 Fiberglass 8 Concrete tile 9 Other (specify below) CASING JOINTS: Glued Clamped Welded Threaded

Blank casing diameter .2 in. to .9 ft, Dia ... in. to ... ft, Dia ... in. to ... ft Casing height above land surface -8.04 in., weight Sch 40 lbs./ft. Wall thickness or gauge No.

TYPE OF SCREEN OR PERFORATION MATERIAL: 1 Steel 2 Brass 3 Stainless steel 4 Galvanized steel 5 Fiberglass 6 Concrete tile 7 PVC 8 RMP (SR) 9 ABS 10 Asbestos-cement 11 Other (specify) 12 None used (open hole)

SCREEN OR PERFORATION OPENINGS ARE: 1 Continuous slot 2 Louvered shutter 3 Mill slot 4 Key punched 5 Gauzed wrapped 6 Wire wrapped 7 Torch cut 8 Saw cut 9 Drilled holes 10 Other (specify) 11 None (open hole)

SCREEN-PERFORATED INTERVALS: From 9 ft to 19 ft, From ... ft to ... ft GRAVEL PACK INTERVALS: From 8 ft to 19 ft, From ... ft to ... ft

6 GROUT MATERIAL: 1 Neat cement 2 Cement grout 3 Bentonite 4 Other Grout Intervals: From 0 ft to 6 ft, From 6 ft to 8 ft, From ... ft to ... ft

What is the nearest source of possible contamination: 1 Septic tank 2 Sewer lines 3 Watertight sewer lines 4 Lateral lines 5 Cess pool 6 Seepage pit 7 Pit privy 8 Sewage lagoon 9 Feedyard 10 Livestock pens 11 Fuel storage 12 Fertilizer storage 13 Insecticide storage 14 Abandoned water well 15 Oil well/Gas well 16 Other (specify below) Former Tank Basins Direction from well? North How many feet? 40

Table with columns FROM, TO, LITHOLOGIC LOG, FROM, TO, PLUGGING INTERVALS. Rows include Sand/Gravel/Clay, Clay, Dark Brown, Clay, Brown/Red Brown, Clay, Brown, and MW3, Tag # 00192626, Flushmount, Project Name: Schaffer Oil Company, GeoCore # 486, KDHE # U6 083 10617

7 CONTRACTOR'S OR LANDOWNER'S CERTIFICATION: This water well was (1) constructed, (2) reconstructed, or (3) plugged under my jurisdiction and was completed on (mo/day/year) 9/2/97 and this record is true to the best of my knowledge and belief. Kansas Water Well Contractor's License No. 527. This Water Well Record was completed on (mo/day/yr) 9/26/97 under the business name of GeoCore Services, Inc. by (signature) Dale Bell