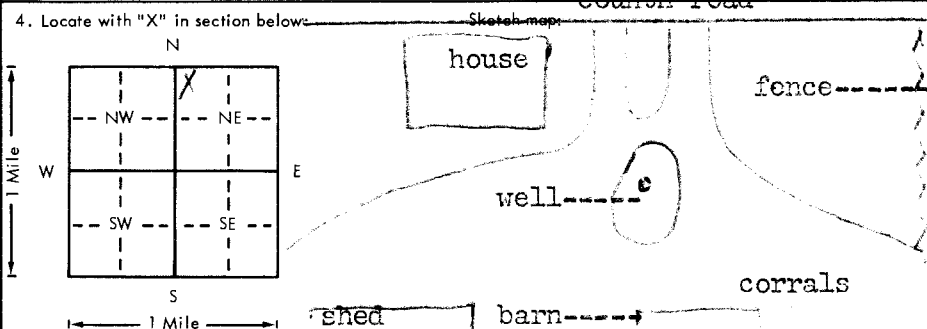


USE TYPEWRITER OR BALL POINT PEN-PRESS FIRMLY, PRINT CLEARLY.

WATER WELL RECORD
KSA 82a-1201-1215

Kansas Department of Health and Environment-Division of Environment
(Water well Contractors)
Topeka, Kansas 66620

1. Location of well:		County Rush	Fraction NW 1/4 NW 1/4 NE 1/4	Section number 10	Township number T 17 S R 18 E W	Range number 18
2. Distance and direction from nearest town or city: 4 north 1 east Street address of well location if in city: La Crosse, Ks.			3. Owner of well: Leonard Herrman R.R. or street: RR. 1 City, state, zip code: La Crosse, Ks.			
4. Locate with "X" in section below: 			6. Bore hole dia. 8 in. Completion date 10-27-79 Well depth 318 ft.			
5. Type and color of material			From	To	7. <input checked="" type="checkbox"/> Cable tool <input checked="" type="checkbox"/> Rotary <input type="checkbox"/> Driven <input type="checkbox"/> Dug <input type="checkbox"/> Hollow rod <input type="checkbox"/> Jetted <input type="checkbox"/> Bored <input type="checkbox"/> Reverse rotary	
topsoil			0	4	8. Use: <input checked="" type="checkbox"/> Domestic <input type="checkbox"/> Public supply <input type="checkbox"/> Industry <input type="checkbox"/> Irrigation <input type="checkbox"/> Air conditioning <input type="checkbox"/> Stock <input type="checkbox"/> Lawn <input type="checkbox"/> Oil field water <input type="checkbox"/> Other	
rocks and clay			4	57	9. Casing: Material PVC Height: Above or below Threaded <input type="checkbox"/> Welded <input checked="" type="checkbox"/> Surface 14 in. RMP <input type="checkbox"/> PVC <input checked="" type="checkbox"/> Weight 200 lbs./ft. Dia. 5 in. to 318 ft. depth Wall Thickness: inches or Dia. <input type="checkbox"/> in. to <input type="checkbox"/> ft. depth gage No. 25	
shale			57	223	10. Screen: Manufacturer's name jet stream Type PVC Dia. 5 Slot 3/32 Length 30 Set between 288 ft. and 318 ft. <input checked="" type="checkbox"/> Gravel pack? <input type="checkbox"/> Size range of material 1/4-1/2	
white dakota clay			223	282	11. Static water level: 200 mo./day/yr. 200 ft. below land surface Date 10-27-79	
sandstone			282	318	12. Pumping level below land surfaces: 200 ft. after 2 hrs. pumping 15 g.p.m. <input type="checkbox"/> ft. after <input type="checkbox"/> hrs. pumping <input type="checkbox"/> g.p.m. Estimated maximum yield 15 g.p.m.	
					13. Water sample submitted: <input checked="" type="checkbox"/> Yes <input type="checkbox"/> No Date	
					14. Well head completion: <input checked="" type="checkbox"/> Pitless adapter <input type="checkbox"/> Inches above grade	
					15. Well grouted? <input checked="" type="checkbox"/> With: <input checked="" type="checkbox"/> Nept cement <input type="checkbox"/> Bentonite <input type="checkbox"/> Concrete Depth: From 4 ft. to 16 ft.	
					16. Nearest source of possible contamination: ft. 800 Direction NS Type stock Well disinfected upon completion? <input checked="" type="checkbox"/> Yes <input type="checkbox"/> No	
					17. Pump: <input type="checkbox"/> Not installed Manufacturer's name FCW Model number 10ba15 HP 1 Volts 220 Length of drop pipe 238 ft. capacity 10 g.p.m. Type: <input checked="" type="checkbox"/> Submersible <input type="checkbox"/> Turbine <input type="checkbox"/> Jet <input type="checkbox"/> Reciprocating <input type="checkbox"/> Centrifugal <input type="checkbox"/> Other	
(Use a second sheet if needed)					20. Water well contractor's certification: This well was drilled under my jurisdiction and this report is true to the best of my knowledge and belief. Karst Water Well 199 Business name E. Hiway 40 License No. Hays, Ks. Address 1/4 NW 1/4 Signed Neil Karst Date 10/27/79 Authorized representative	
18. Elevation:		19. Remarks:				
Topography: <input type="checkbox"/> Hill <input checked="" type="checkbox"/> Slope <input type="checkbox"/> Upland <input type="checkbox"/> Valley						

17-18-19-20
W
E
10
1/4 NW 1/4

Forward the white, blue and pink copies to the Department of Health and Environment

Form WWC-5