USE TYPEWRITER OR BALL POINT PEN-PRESS FIRMLY, PRINT CLEARLY.

T R EW sec 1/4 1/4 1/4 No.

WATER WELL RECORD
KSA 82a-1201-1215

Kansas State Dept. Of Health
(Water Well Contractors)
Forbes-Bldg. 740
Topeka, Kansas 66620

1 Location of well:	County	Township name	Fraction	Section number	Town number	Range number
	Rush	LaCrosse	SW¼SE¼NE¼	24	17	18

Distance and direction from nearest town or city:
4 Miles North East of LaCroose
Street address of well location if in city:

3 Owner of well: Wayne Ficken
Address: LaCrosse, Kansas

Locate with "X" in section below:

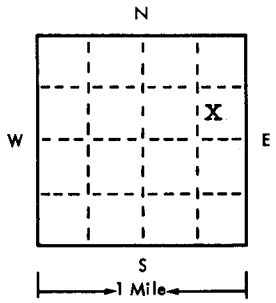

Sketch map:

4 Well depth: 27 ft. Date of completion 4-7-75
Well diameter 5 in.

5 ☐ Cable tool ☒ Rotary ☐ Driven ☐ Dug
☐ Hollow rod ☐ Jetted ☐ Bored ☐ Reverse rotary

6 Use: ☒ Domestic ☐ Public supply ☐ Industry
☐ Irrigation ☐ Air conditioning ☐ Commercial
☐ Test well ☐

7 Casing: Material PVC Height: above/below
Threaded ☐ Welded ☐ Surface 3 ft above
Diam. Bonded Weight 200 lbs./ft. 1
5 in. to 27 ft. depth Drive shoe? ☐ Yes ☒ No
in. to ft. depth

2

Type and color of material	From	To
Clay material light and dark	1'	20'
Rock & Gravel	20'	26'
Shale	26'	27'

(use a second sheet if needed)

8 Screen:
Manufacturer Jess & Lowell
Type Styrene Dia. 5"
Slot/gauze Slot Length 10'
Set between Bottom to 10 ft. and ft.
Fittings:
Gravel pack ☒ Yes ☐ No Size range of material

9 Static water level:
6 ft. below land surface Date 4-7-75

10 Pumping level below land surfaces:
6 ft. after 1 hrs. pumping 20 g.p.m.
ft. after hrs. pumping g.p.m.
Estimated maximum yield 25 g.p.m.

11 Water sample submitted:
☐ Yes ☒ No Date 4-7-75

12 Well head completion:
☐ Pitless adapter ☒ Inches above grade

13 Well grouted? ☒ Yes ☐ No
☒ Neat cement ☐ Bentonite ☐
Depth: From 1 ft. to 10 ft.

14 Nearest source of possible contamination:
ft. 600 Direction East Type Barn Yard
Well disinfected upon completion? ☒ Yes ☐ No

15 Pump: ☒ Not installed
Manufacturer's name
Model number HP Volts
Length of drop pipe ft. capacity g.m.p.
Type:
☐ Submersible ☐ Turbine
☐ Jet ☐ Reciprocating
☐ Centrifugal ☐ Other

16 Remarks: elevation Nearly Level 2060
26
34

Topagraphy:
☐ Hill
☐ Slope
☐ Upland
☒ Valley

17 Water well contractor's certification:
This well was drilled under my jurisdiction and this report is true to the best of my knowledge and belief.
Business name Water Well Sales License No.
Address East 8th Hays, Kans.
Signed Date
Authorized representative

Forward the white, blue and pink copies to the Kansas State Dept. Of Health.

Form WWC-5

677-H