


MW13

☒ Original Record    ☐ Correction    ☐ Change in Well Use

Well ID

[illegible]

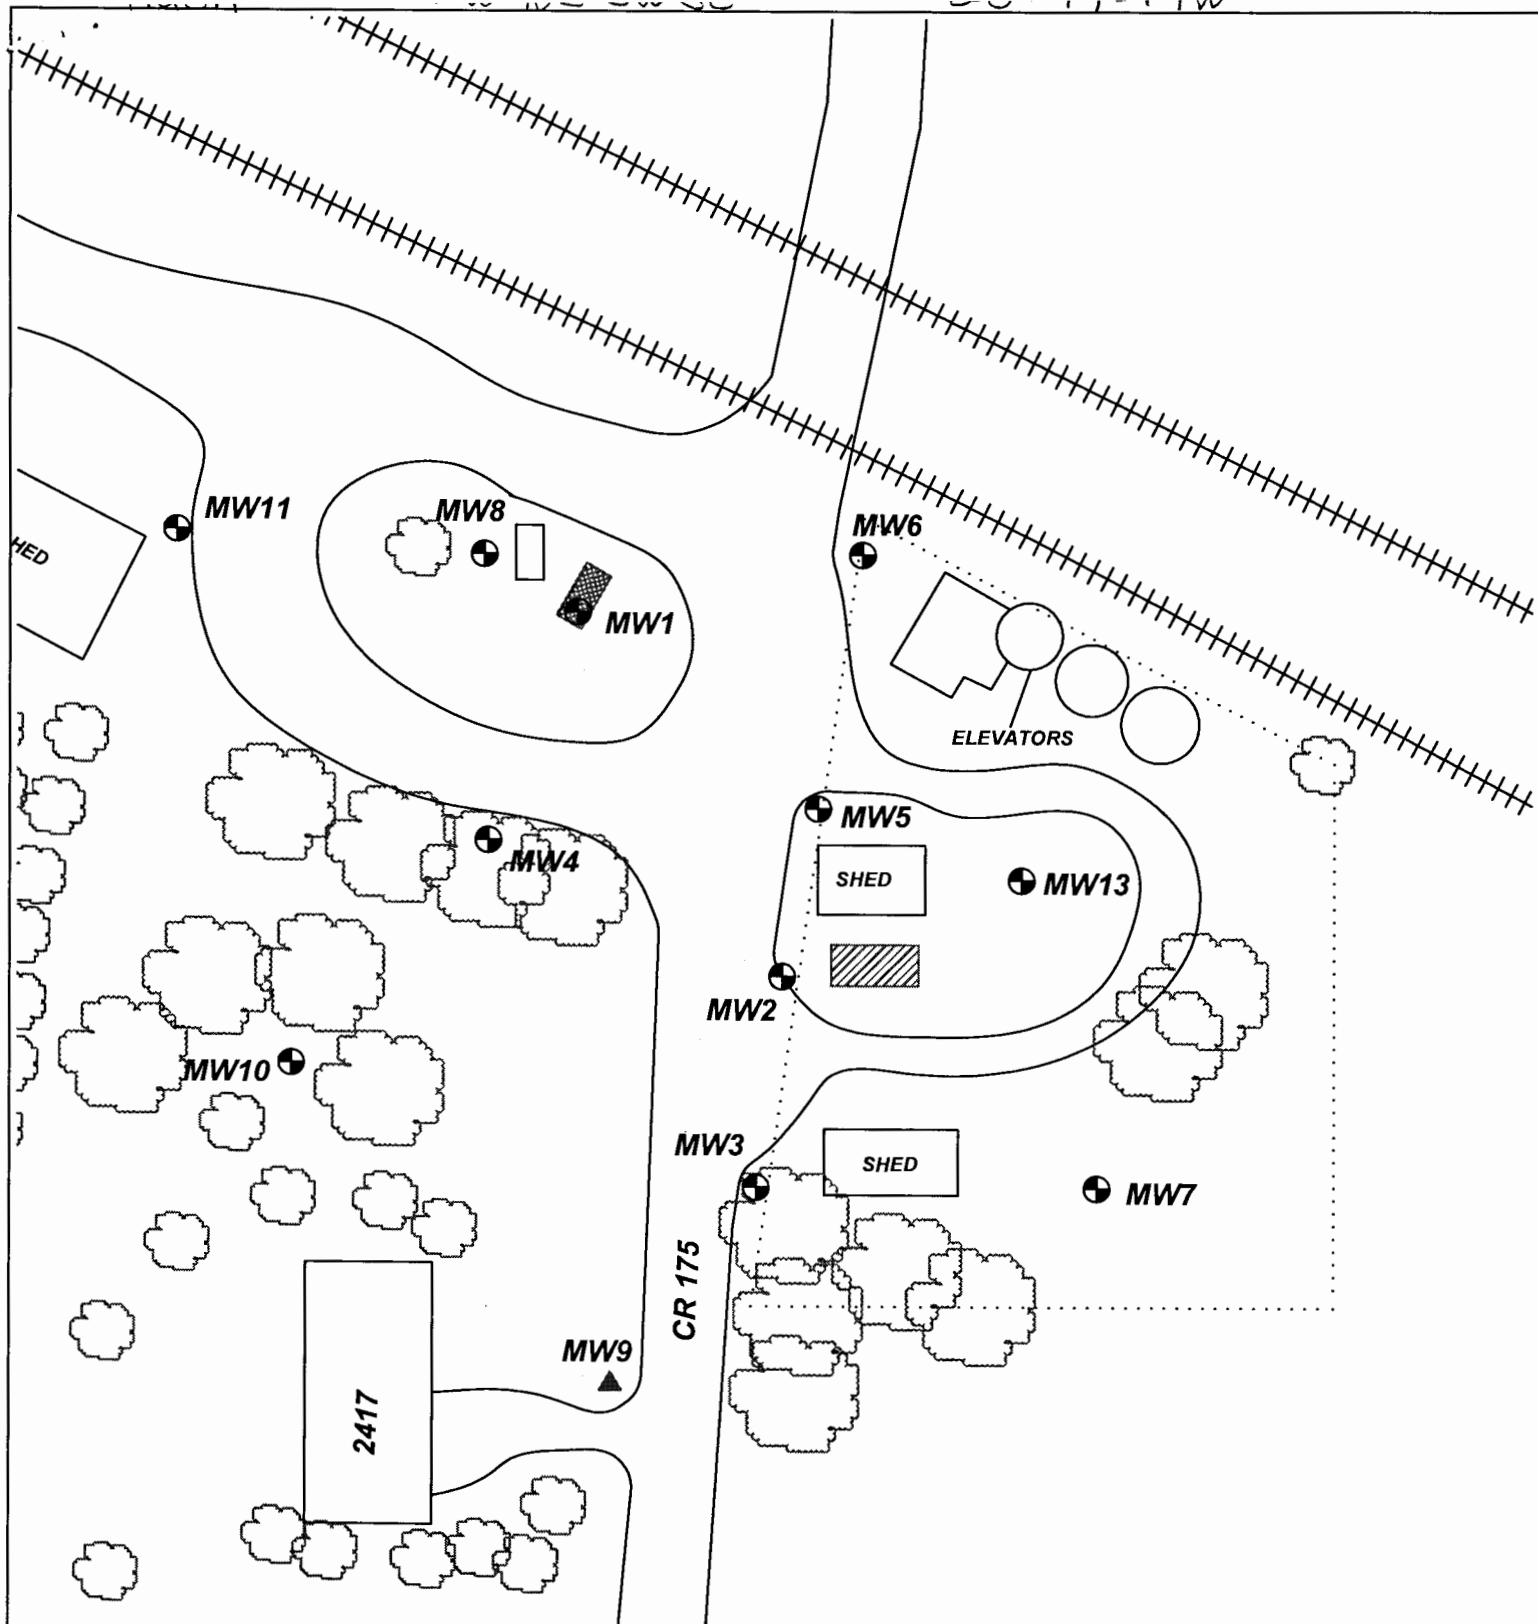

PROJECT: **MORAN, JAMES C.**

ADDRESS: **RR1 BOX 108**


LOCATION: **HARGRAVE, KS**

DRAWN BY: **B. STALNAKER** DATE: **1/7/18**

REVISED BY: **B. STALNAKER** DATE: **1/17/18**

AEI JOB #: **TF175** KDHE JOB #: **U6-083-00806**

SCALE: **1" = 50'**

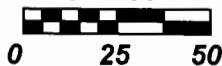

NOTES:  
No basements observed within 500'.

TITLE:

## FIGURE 2.1 AREA BASE MAP CLOSE-UP



**ASSOCIATED  
ENVIRONMENTAL  
INC.**

LEGEND:

■ = FORMER 10,000 GAL GASOLINE UST

■ = FORMER 750 GAL GASOLINE,  
1000 GAL GASOLINE USTs

⊕ = MONITORING WELL

▲ = PLUGGED/DESTROYED WELL

..... = SUBJECT PROPERTY

