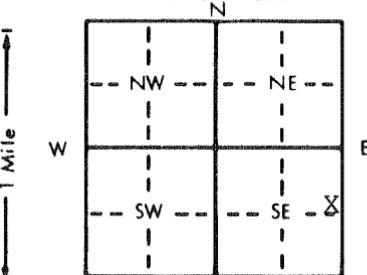


1 LOCATION OF WATER WELL:		Fraction		Section Number		Township Number		Range Number			
County: Rush		SE 1/4 NE 1/4 SE 1/4		7		T 17 S		R 20 E			
Distance and direction from nearest town or city street address of well if located within city?						52915019		MW-2			
Approx. 180' West & 75' North of the center of Beech & Washington Streets, McCracken, KS											
2 WATER WELL OWNER: Charlie's Service											
RR#, St. Address, Box # : 401 Washington					Board of Agriculture, Division of Water Resources						
City, State, ZIP Code : McCracken, KS 67556					Application Number:						
3 LOCATE WELL'S LOCATION WITH AN "X" IN SECTION BOX:		4 DEPTH OF COMPLETED WELL: 37 ft. ELEVATION: Approx. Surf. Elev.: 2,135									
		Depth(s) Groundwater Encountered 1. 25.7 ft. 2. ft. 3. ft.									
		WELL'S STATIC WATER LEVEL 26.0 ft. below land surface measured on mo/day/yr 05/17/91									
		Pump test data: Well water was ft. after hours pumping gpm									
		Est. Yield N/A gpm: Well water was ft. after hours pumping gpm									
		Bore Hole Diameter 8.25 in. to 37 ft. and in. to									
		WELL WATER TO BE USED AS: 5 Public water supply 8 Air conditioning 11 Injection well									
		1 Domestic 3 Feedlot 6 Oil field water supply 9 Dewatering 12 Other (Specify below)									
		2 Irrigation 4 Industrial 7 Lawn and garden only 10 Monitoring well									
		Was a chemical/bacteriological sample submitted to Department? Yes No X; If yes, mo/day/yr sample was submitted									
		Water Well Disinfected? Yes No X									
5 TYPE OF BLANK CASING USED:											
1 Steel 3 RMP (SR) 5 Wrought iron 8 Concrete tile CASING JOINTS: Glued Clamped											
2 PVC 4 ABS 6 Asbestos-Cement 9 Other (specify below) Welded											
7 Fiberglass Threaded X											
Blank casing diameter 2 in. to 17 ft. Dia in. to ft. Dia in. to ft.											
Casing height above land surface -2 in. weight lbs./ft. Wall thickness or gauge No. Schedule 40											
TYPE OF SCREEN OR PERFORATION MATERIAL:											
1 Steel 3 Stainless steel 5 Fiberglass 7 PVC 10 Asbestos-cement											
2 Brass 4 Galvanized steel 6 Concrete tile 8 RMP (SR) 11 Other (specify)											
9 ABS 12 None used (open hole)											
SCREEN OR PERFORATION OPENINGS ARE:											
1 Continuous slot 3 Mill slot 5 Gauzed wrapped 8 Saw cut 11 None (open hole)											
2 Louvered shutter 4 Key punched 6 Wire wrapped 9 Drilled holes											
7 Torch cut 10 Other (specify)											
SCREEN-PERFORATED INTERVALS: From 17 ft. to 37 ft. From ft. to ft.											
From ft. to ft. From ft. to ft.											
GRAVEL PACK INTERVALS: From 13 ft. to 37 ft. From ft. to ft.											
From ft. to ft. From ft. to ft.											
6 GROUT MATERIAL: 1 Neat cement 2 Cement grout 3 Bentonite 4 Other											
Grout intervals: From 0 ft. to 11 ft. From 11 ft. to 13 ft. From ft. to ft.											
What is the nearest source of possible contamination:											
1 Septic tank 4 Lateral lines 7 Pit privy 10 Livestock pens 14 Abandoned water well											
2 Sewer lines 5 Cess pool 8 Sewage lagoon 11 Fuel storage 15 Oil well/Gas well											
3 Watertight sewer lines 6 Seepage pit 9 Feedyard 12 Fertilizer storage 16 Other (specify below)											
13 Insecticide storage											
Direction from well? North/Northeast How many feet? 25											
FROM		TO		LITHOLOGIC LOG		FROM		TO		PLUGGING INTERVALS	
0		2.5		Dark Brown Lean Clay							
2.5		7.0		Brown Lean Clay							
7.0		15.0		Light Brown Lean Clay							
15.0		37.0		Brown Lean Clay							
7 CONTRACTOR'S OR LANDOWNER'S CERTIFICATION: This water well was (1) constructed, (2) reconstructed, or (3) plugged under my jurisdiction and was completed on (mo/day/year) 05/14/91 and this record is true to the best of my knowledge and belief. Kansas											
Water Well Contractor's License No. 416 This Water Well Record was completed on (mo/day/yr) 9/30/91											
under the business name of Terracon Consultants, Inc. by (signature)											
INSTRUCTIONS: Use typewriter or ball point pen. PLEASE PRESS FIRMLY and PRINT clearly. Please fill in blanks, underline or circle the correct answers. Send top three copies to Kansas Department of Health and Environment, Bureau of Water, Topeka, Kansas 66620-0001. Telephone: 913-296-5545. Send one to WATER WELL OWNER and retain one for your records.											