


1 LOCATION OF WATER WELL: County: Ness Fraction: ne 1/4 sw 1/4 se 1/4 Section Number: 32 Township Number: T 17 S Range Number: R 21 EW

Distance and direction from nearest town or city street address of well if located within city? 5 1/4 miles north-1 east of Bazine, Ks.

2 WATER WELL OWNER: Mildred Sauser RR#, St. Address, Box #: 5225 Eisenhower Board of Agriculture, Division of Water Resources City, State, ZIP Code: Great Bend, Ks. 67530 Application Number:

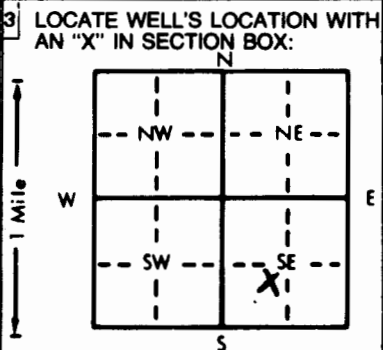

4 DEPTH OF COMPLETED WELL: 30 ft. ELEVATION: WELL'S STATIC WATER LEVEL: 1.4 ft. below land surface measured on mo/day/yr 3-24-86

5 TYPE OF BLANK CASING USED: 1 Steel, 3 RMP (SR), 5 Wrought iron, 8 Concrete tile, 6 Asbestos-Cement, 9 Other (specify below), 7 Fiberglass, CASING JOINTS: Glued, Clamped, Welded, Threaded.

6 GROUT MATERIAL: 1 Neat cement, 2 Cement grout, 3 Bentonite, 4 Other. Grout Intervals: From 0 ft. to 10 ft. What is the nearest source of possible contamination: 1 Septic tank, 2 Sewer lines, 3 Watertight sewer lines, 4 Lateral lines, 5 Cess pool, 6 Seepage pit, 7 Pit privy, 8 Sewage lagoon, 9 Feedyard, 10 Livestock pens, 11 Fuel storage, 12 Fertilizer storage, 13 Insecticide storage, 14 Abandoned water well, 15 Oil well/Gas well, 16 Other (specify below), none.

Table with columns FROM, TO, LITHOLOGIC LOG. Rows: 0-7 Brown top soil, 7-17 Silty light brown clay, 17-28 Soft brown clay with cletche and sand mixed, 28-32 Hard gray shale.

7 CONTRACTOR'S OR LANDOWNER'S CERTIFICATION: This water well was (1) constructed, (2) reconstructed, or (3) plugged under my jurisdiction and was completed on (mo/day/year) 5-1-86 and this record is true to the best of my knowledge and belief. Kansas Water Well Contractor's License No. 134 This Water Well Record was completed on (mo/day/yr) 7-10-86 under the business name of Rosencrantz-Bemis by (signature) Fredia Rodson

INSTRUCTIONS: Use typewriter or ball point pen. PLEASE PRESS FIRMLY and PRINT clearly. Please fill in blanks, underline or circle the correct answers. Send top three copies to Kansas Department of Health and Environment, Office of Oil Field and Environmental Geology, Regulation and Permitting Section, Topeka, Kansas 66620-7500, Telephone: 913-862-9360. Send one to WATER WELL OWNER and retain one for your records.

OFFICE USE ONLY T R EW SEC 1/4 1/4 1/4 1/4