


1	LOCATION OF WATER WELL:	Fraction	Section Number	Township Number	Range Number
County: <u>Miss</u>		<u>1/4 NE 1/4 SE 1/4</u>	<u>5 175</u>	<u>23W</u>	<u>E/W</u>

Distance and direction from nearest town or city street address of well if located within city?

2 WATER WELL OWNER: Craig + Carol Blackstone
 RR #, St. Address, Box #: Rt 1 Box 120
 City, State, ZIP Code: Ransom, KS 67572
 Board of Agriculture, Division of Water Resources
 Application Number: _____

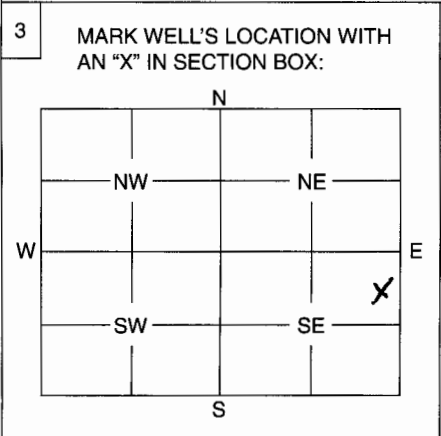

4 DEPTH OF WELL 115 ft.
 WELL'S STATIC WATER LEVEL 21 ft.
 WELL WAS USED AS:
 1 Domestic
 2 Irrigation
 3 Feedlot
 4 Industrial
 5 Public Water Supply
 6 Oil Field Water Supply
 7 Domestic (Lawn & Garden)
 8 Air Conditioning
 9 Dewatering
 10 Monitoring Well
 11 Injection Well
 12 Other

Was a chemical / bacteriological sample submitted to Department? Yes No X.....
 If yes, mo/day/yr sample was submitted

Water Well Disinfected: Yes X No

5 TYPE OF BLANK CASING USED:
 1 Steel 3 RMP (SR) 5 Wrought 7 Fiberglass 9 Other (Specify below)
 2 PVC 4 ABS 6 Asbestos-Cement 8 Concrete Tile

Blank casing diameter 7 in. Was casing pulled? Yes X No If yes, how much 3 ft.
 Casing height above or below land surface 0 in.

6 GROUT PLUG MATERIAL: 1 Neat cement 2 Cement grout 3 Bentonite 4 Other

Grout Plug Intervals: From 3 ft. to 6 ft., From ft. to ft., From to ft.

What is the nearest source of possible contamination:
 1 Septic tank 6 Seepage pit 11 Fuel storage 16 Other (specify below)
 2 Sewer lines 7 Pit privy 12 Fertilizer storage
 3 Watertight sewer lines 8 Sewage lagoon 13 Insecticide storage
 4 Lateral lines 9 Feedyard 14 Abandoned water well
 5 Cess pool 10 Livestock pens 15 Oil well/Gas well

Direction from well? West How many feet? 600

FROM	TO	PLUGGING MATERIALS
<u>115</u>	<u>20</u>	<u>Clean Sand</u>
<u>20</u>	<u>6</u>	<u>Soil</u>
<u>6</u>	<u>3</u>	<u>Bentonite</u>
<u>3</u>	<u>0</u>	<u>Soil</u>

7 CONTRACTOR'S OF LANDOWNER'S CERTIFICATION: This water well was plugged under my jurisdiction and was completed on (mo/day/year) 5-25-2007 and this record is true to the best of my knowledge and belief. Kansas Water Well Contractor's License No. This Water Well Record was completed on (mo/day/year) 6-6-2007
 by (signature) Richard Craig Blackstone

INSTRUCTIONS: Use typewriter or ball point pen. Please press firmly and print clearly. Please fill in blanks, underline or circle the correct answers. Send top three copies to Kansas Department of Health and Environment, Bureau of Water, Geology Section, 1000 SW Jackson St., Ste. 420, Topeka, Kansas 66612-1367. Telephone: 785/296-5522. Send one to Water Well Owner and retain one for your records.