


1 LOCATION OF WATER WELL: Fraction SW 1/4 SW 1/4 NE 1/4 Section Number 19 Township Number T 17 S Range Number R 23 E
 County: Ness

Distance and direction from nearest town or city street address of well if located within city?
1/2 mile north of Ness city West side of Hiway # 283

2 WATER WELL OWNER: J.M. Tuttle - subcontractor of wet walnut creek
 RR#, St. Address, Box #: RR1 Box 50 Sub watershed # 3 Board of Agriculture, Division of Water Resources
 City, State, ZIP Code: Gore KS 67734 Dam site # 42 Application Number: 38,617

3 LOCATE WELL'S LOCATION WITH AN "X" IN SECTION BOX:

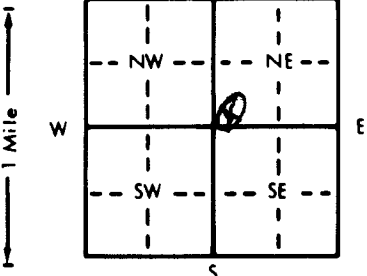

4 DEPTH OF COMPLETED WELLS 20 ft. ELEVATION: _____

Depth(s) Groundwater Encountered 1. 3 ft. ft. 2. _____ ft. 3. _____ ft.
 WELL'S STATIC WATER LEVEL 3 ft. ft. below land surface measured on mo/day/yr 3-2-87
 Pump test data: Well water was _____ ft. after _____ hours pumping _____ gpm
 Est. Yield _____ gpm: Well water was _____ ft. after _____ hours pumping _____ gpm
 Bore Hole Diameter 8 in. to _____ ft., and _____ in. to _____ ft.
 WELL WATER TO BE USED AS:
 5 Public water supply 8 Air conditioning 11 Injection well
 1 Domestic 3 Feedlot 6 Oil field water supply 9 Dewatering 12 Other (Specify below)
 2 Irrigation 4 Industrial 7 Lawn and garden only 10 Observation well
 Was a chemical/bacteriological sample submitted to Department? Yes _____ No X _____; If yes, mo/day/yr sample was submitted _____
 Water Well Disinfected? Yes _____ No X _____

5 TYPE OF BLANK CASING USED:
 1 Steel 3 RMP (SR) 5 Wrought iron 8 Concrete tile CASING JOINTS: Glued X Clamped _____
2 PVC 4 ABS 7 Fiberglass _____ Welded _____
 Blank casing diameter 5 in. to 10+2 ft., Above in. to _____ ft., Dia. _____ in. to _____ ft.
 Casing height above land surface 2 ft. in., weight 5.17 40 lbs./ft. Wall thickness or gauge No. 200

TYPE OF SCREEN OR PERFORATION MATERIAL:
 1 Steel 3 Stainless steel 5 Fiberglass 8 RMP (SR) 10 Asbestos-cement
 2 Brass 4 Galvanized steel 6 Concrete tile 9 ABS 12 None used (open hole)
 SCREEN OR PERFORATION OPENINGS ARE:
 1 Continuous slot 3 Mill slot 5 Gauzed wrapped 8 Saw cut 11 None (open hole)
 2 Louvered shutter 4 Key punched 6 Wire wrapped 9 Drilled holes
 7 Torch cut 10 Other (specify) _____

SCREEN-PERFORATED INTERVALS: From 10' ft. to 20' ft., From _____ ft. to _____ ft.
 From _____ ft. to _____ ft., From _____ ft. to _____ ft.
 GRAVEL PACK INTERVALS: From 8' ft. to 20' ft., From _____ ft. to _____ ft.
 From _____ ft. to _____ ft., From _____ ft. to _____ ft.

6 GROUT MATERIAL: 1 Neat cement 2 Cement grout 3 Bentonite 4 Other clay
 Grout Intervals: From 0 ft. to 8 ft., From _____ ft. to _____ ft., From _____ ft. to _____ ft.

What is the nearest source of possible contamination:
 1 Septic tank 4 Lateral lines 7 Pit privy 10 Livestock pens 14 Abandoned water well
 2 Sewer lines 5 Cess pool 8 Sewage lagoon 11 Fuel storage 15 Oil well/Gas well
 3 Watertight sewer lines 6 Seepage pit 9 Feedyard 12 Fertilizer storage 6 Other (specify below) Creek bed
 13 Insecticide storage _____

Direction from well? Livestock Pens - East How many feet? 0 - 300 ft

FROM	TO	LITHOLOGIC LOG	FROM	TO	LITHOLOGIC LOG
		Group of 9 wells 5 above 4 below Core trench on NE end of Dam in valley	0	3	black dirt
			3	20	sand shale wash w/ streaks of clay @ 12-13'
			20	21	Hardened shale (yellow)

7 CONTRACTOR'S OR LANDOWNER'S CERTIFICATION: This water well was 1 constructed, (2) reconstructed, or (3) plugged under my jurisdiction and was completed on (mo/day/year) 3-4-87 and this record is true to the best of my knowledge and belief. Kansas Water Well Contractor's License No. 489 This Water Well Record was completed on (mo/day/yr) 8-15-87
 under the business name of Aqua Drilling by (signature) J.M. Tuttle

OFFICE USE ONLY
T
R
EW
SEC.