USE TYPEWRITER OR BALL POINT PEN-PRESS FIRMLY, PRINT CLEARLY.

within N
Well #3

WATER WELL RECORD
KSA 82a-1201-1215

Kansas Department of Health and Environment-Division of Environment
(Water well Contractors)
Topeka, Kansas 66620

D A A

1. Location of well:	County	Fraction	Section number	Township number	Range number
	NESS	NE 1/4 NE 1/4 NE 1/4	12	T 17 S	R 25 E/W

2. Distance and direction from nearest town or city: 4 miles W 4 mile SW 1/2, 2 1/2 S. of RANSOM, KS.
Street address of well location if in city:

3. Owner of well: OLIVER TILLITSON
R.R. or street:
City, state, zip code: RANSOM, KANSAS 67502

X Locate with "X" in section below:

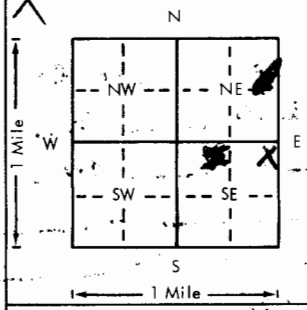

Sketch map:

PASTURE

6. Bore hole dia. 9 in. Completion date 10/2/78
Well depth 32 ft.

X Cable tool X Rotary Driven Dug
Hollow rod Jetted Bored Reverse rotary

8. Use: X Domestic Public supply Industry
Irrigation Air conditioning X Stock
Lawn Oil field water Other

9. Casing: Material PLASTIC Height: Above or below
Threaded Welded glued Surface 18" in.
RMP PVC X Weight lbs./ft.
Dia. 5 in. to 32 ft. depth Wall Thickness: inches or
Dia. in. to ft. depth gage No. .250

5. Type and color of material	From	To
CLAY	0	27
SAND & Gravel	27	30
ROCK	30	32
BROCK 32		
22		
10		
2435		
(Use a second sheet if needed) 32 403		

10. Screen: Manufacturer's name CROWN LINE PLASTICS INC
Type PLASTIC Dia. 5"
Slot/gauze 1/16 Length 10'
Set between 32 ft. and 22 ft.
ft. and ft.
Gravel pack? yes Size range of material 1/4 - 5/8

11. Static water level: mo./day/yr.
22 ft. below land surface Date 10/2/78

12. Pumping level below land surfaces: NOT pumped
ft. after hrs. pumping g.p.m.
ft. after hrs. pumping g.p.m.
Estimated maximum yield g.p.m.

13. Water sample submitted: mo./day/yr.
Yes X No Date

14. Well head completion: NOT done
Pitless adapter Inches above grade

15. Well grouted? yes
With: X Neat cement Bentonite Concrete
Depth: From 0 ft. to 10 ft.

16. Nearest source of possible contamination: NONE
ft. PASTURE LAND Direction Type KNOWN
Well disinfected upon completion? X Yes No

17. Pump: X Not installed
Manufacturer's name
Model number HP Volts
Length of drop pipe ft. capacity g.p.m.
Type:
Submersible Turbine
Jet Reciprocating
Centrifugal Other

T 17 R 25 (W) E Sec 12 NE NE NE 1/4 1/4 1/4

18. Elevation:

Topography:
X Hill
Slope
Upland
Valley

19. Remarks:
CONCRETE SLAB TO be INSTALLED AT GROUND SURFACE by CUSTOMER.

20. Water well contractor's certification:
This well was drilled under my jurisdiction and this report is true to the best of my knowledge and belief.
D&L DRILLING CO 303
Business name License No.
Address BOX 368 HILL CITY, KS. 67642
Signed Allen Jasmin Authorized representative Date 4-19-79

Forward the white, blue and pink copies to the Department of Health and Environment

Form WWC-5

MI-1023