


1 LOCATION OF WATER WELL: Fraction SW 1/4 SW 1/4 SW 1/4 Section Number 36 Township Number T 17 S Range Number R 27 EW

Distance and direction from nearest town or city street address of well if located within city? 9E + 3N + 2E OF DIGHTON, KS.

2 WATER WELL OWNER: JIM BROWN RR#, St. Address, Box #: BOX 440 City, State, ZIP Code: DEERLETT, KS 67518 Board of Agriculture, Division of Water Resource Application Number:

3 LOCATE WELL'S LOCATION WITH AN "X" IN SECTION BOX: 4 DEPTH OF COMPLETED WELL: 55 ft. ELEVATION:

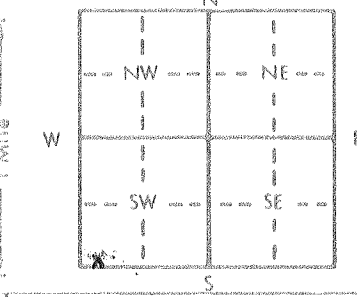

Depth(s) Groundwater Encountered 1. 31 ft. 2. ft. 3. ft. WELL'S STATIC WATER LEVEL 31 ft. below land surface measured on mo/day/yr Pump test data: Well water was ft. after hours pumping gpm Est. Yield gpm: Well water was ft. after hours pumping gpm Bore Hole Diameter in. to ft., and in. to ft. WELL WATER TO BE USED AS: 5 Public water supply 8 Air conditioning 11 Injection well 1 Domestic 3 Feedlot 6 Oil field water supply 9 Dewatering 12 Other (Specify below) 2 Irrigation 4 Industrial 7 Lawn and garden only 10 Monitoring well Was a chemical/bacteriological sample submitted to Department? Yes No; If yes, mo/day/yr sample was submitted Water Well Disinfected? Yes No

5 TYPE OF BLANK CASING USED: 1 Steel 3 RMP (SR) 5 Wrought iron 8 Concrete tile CASING JOINTS: Glued Clamped Welded Threaded 2 PVC 4 ABS 6 Asbestos-Cement 9 Other (specify below) 7 Fiberglass

Blank casing diameter 4 in. to ft., Dia in. to ft., Dia in. to ft. Casing height above land surface 78 in., weight lbs./ft. Wall thickness or gauge No.

TYPE OF SCREEN OR PERFORATION MATERIAL: 1 Steel 3 Stainless steel 5 Fiberglass 7 PVC 10 Asbestos-cement 2 Brass 4 Galvanized steel 6 Concrete tile 8 RMP (SR) 11 Other (specify) NA 9 ABS 12 None used (open hole)

SCREEN OR PERFORATION OPENINGS ARE: 1 Continuous slot 3 Mill slot 5 Gauzed wrapped 8 Saw cut 11 None (open hole) 2 Louvered shutter 4 Key punched 6 Wire wrapped 9 Drilled holes 7 Torch cut 10 Other (specify) NA

SCREEN-PERFORATED INTERVALS: From 999 ft. to 999 ft. From ft. to ft. From ft. to ft. From ft. to ft.

GRAVEL PACK INTERVALS: From ft. to ft. From ft. to ft. From ft. to ft. From ft. to ft.

6 GROUT MATERIAL: 1 Neat cement 2 Cement grout 3 Bentonite 4 Other Grout Intervals: From 31 ft. to 4 ft. From ft. to ft. From ft. to ft. From ft. to ft.

What is the nearest source of possible contamination: 1 Septic tank 4 Lateral lines 7 Pit privy 10 Livestock pens 14 Abandoned water well 2 Sewer lines 5 Cess pool 8 Sewage lagoon 11 Fuel storage 15 Oil well/Gas well 3 Watertight sewer lines 6 Seepage pit 9 Feedyard 12 Fertilizer storage 16 Other (specify below) 13 Insecticide storage

Direction from well? How many feet?

FROM	TO	LITHOLOGIC LOG	FROM	TO	PLUGGING INTERVALS
					55 ft. 1/2 in DEEP? 6 ft. 8 in OF WATER? DISINFECTED WASHED SAND BENTONITE DIRT - TOP SOIL
			31' 4"	55' 4"	
			4'	31' 4"	
			0'	4'	

7 CONTRACTOR'S OR LANDOWNER'S CERTIFICATION: This water well was (1) constructed, (2) reconstructed, or (3) plugged under my jurisdiction and was completed on (mo/day/year) 11-30-96 and this record is true to the best of my knowledge and belief. Kansas Water Well Contractor's License No. 423 This Water Well Record was completed on (mo/day/yr) 11-30-96 under the business name of Claire Dredging Co. by (signature) Jack D. Claire