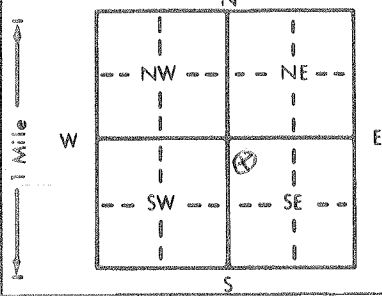


1 LOCATION OF WATER WELL: Fraction SW 1/4 SW 1/4 NE 1/4 Section Number 28 Township Number T 17 S Range Number R 27 **W**

Distance and direction from nearest town or city street address of well if located within city?  
 From Dighton: 5 E, 5 N, 3 1/2 E, 1/2 S.

2 WATER WELL OWNER: Van W. Hanks  
 RR#, St. Address, Box # : RFD Board of Agriculture, Division of Water Resource  
 City, State, ZIP Code : Shields, KS 67874 Application Number: 15841

3 LOCATE WELL'S LOCATION WITH AN "X" IN SECTION BOX:  


4 DEPTH OF COMPLETED WELL: 141 ft. ELEVATION:  
 Depth(s) Groundwater Encountered 1... 90... ft. 2... ft. 3... ft.  
 WELL'S STATIC WATER LEVEL: 90 ft. below land surface measured on mo/day/yr  
 Pump test data: Well water was 130 ft. after 3 hours pumping 209 gpm  
 Est. Yield 209 gpm: Well water was ft. after hours pumping gpm  
 Bore Hole Diameter 36 in. to 141 ft., and in. to ft.  
 WELL WATER TO BE USED AS:  
 5 Public water supply 8 Air conditioning 11 Injection well  
 1 Domestic 3 Feedlot 6 Oil field water supply 9 Dewatering 12 Other (Specify below)  
 2 Irrigation 4 Industrial 7 Lawn and garden only 10 Monitoring well  
 Was a chemical/bacteriological sample submitted to Department? Yes... No... **XX**; If yes, mo/day/yr sample was submitted  
 Water Well Disinfected? Yes No

5 TYPE OF BLANK CASING USED:  
 1 Steel 3 RMP (SR) 5 Wrought iron 8 Concrete tile CASING JOINTS: Glued Clamped  
 2 PVC 4 ABS 6 Asbestos-Cement 9 Other (specify below) Welded **XX**  
 7 Fiberglass Threaded

Blank casing diameter 16 in. to 141 ft., Dia in. to ft., Dia in. to ft.  
 Casing height above land surface 24 in., weight lbs./ft. Wall thickness or gauge No. 250

TYPE OF SCREEN OR PERFORATION MATERIAL:  
 1 Steel 3 Stainless steel 5 Fiberglass 7 PVC 10 Asbestos-cement  
 2 Brass 4 Galvanized steel 6 Concrete tile 8 RMP (SR) 11 Other (specify)  
 12 None used (open hole)

SCREEN OR PERFORATION OPENINGS ARE:  
 1 Continuous slot 3 Mill slot 5 Gauzed wrapped 8 Saw cut 11 None (open hole)  
 2 Louvered shutter 4 Key punched 6 Wire wrapped 9 Drilled holes  
 7 Torch cut 10 Other (specify)

SCREEN-PERFORATED INTERVALS: From 121 ft. to 141 ft., From ft. to ft.  
 GRAVEL PACK INTERVALS: From ft. to ft., From ft. to ft.

6 GROUT MATERIAL: 1 Neat cement 2 Cement grout 3 Bentonite 4 Other  
 Grout Intervals: From 20 ft. to 0 ft., From ft. to ft., From ft. to ft.  
 What is the nearest source of possible contamination:  
 1 Septic tank 4 Lateral lines 7 Pit privy 10 Livestock pens 14 Abandoned water well  
 2 Sewer lines 5 Cess pool 8 Sewage lagoon 11 Fuel storage 15 Oil well/Gas well  
 3 Watertight sewer lines 6 Seepage pit 9 Feedyard 12 Fertilizer storage 16 Other (specify below)  
 13 Insecticide storage

Direction from well? How many feet?

FROM	TO	LITHOLOGIC LOG	FROM	TO	PLUGGING INTERVALS
0	2	Top Soil	121	123	Brown Sandy Clay
2	7	Brown Sandy Clay	123	126	Sand Fine to Med. Coarse
7	25	Brown & Tan Clay w/Some Cemented Sand Strips	126	131	Sm. Gravel
25	33	Sand Fine to Med. Coarse	131	142	Yellow Soap Stone
33	35	Cemented Sand			Shale
35	66	Sand Fine to Med. Coarse w/Some Sm. Clay Strips			
66	71	Brown Sandy Clay			
71	97	Sand Fine to Med. Coarse Some Sm. Gravel			
97	109	Sand Fine to Med. Coarse Sm. Gravel			
109	121	Sand Fine to Med. Coarse Sm. to Some Lg. Gravel			

7 CONTRACTOR'S OR LANDOWNER'S CERTIFICATION: This water well was (1) constructed, (2) reconstructed, or (3) plugged under my jurisdiction and was completed on (mo/day/year) 06-27-91 and this record is true to the best of my knowledge and belief. Kansas Water Well Contractor's License No. KS. 514. This Water Well Record was completed on (mo/day/yr) 07-08-91 under the business name of Miller Gearhead & Pump Repair, Inc. by (signature) Everett Miller