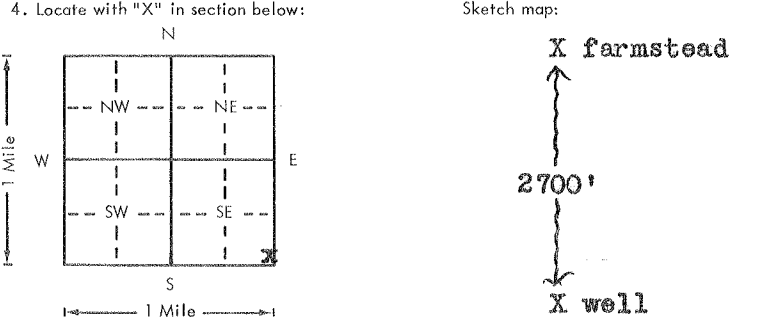


USE TYPEWRITER OR BALL POINT PEN—PRESS FIRMLY, PRINT CLEARLY.

WATER WELL RECORD
KSA 82a-1201-1215

Kansas Department of Health and Environment—Division of Environment (Water well Contractors) Topeka, Kansas 66620

1. Location of well:	County Lane	Fraction S/E 1/4 S/E 1/4 S/E 1/4	Section number 33	Township number T 17 S R	Range number 27 E/W
2. Distance and direction from nearest town or city: 9 E., 3 1/2 N. of Dighton, Kansas Street address of well location if in city:			3. Owner of well: Delmar Mamma R.R. or street: Alamota, Kansas 67830 City, state, zip code:		
4. Locate with "X" in section below: 			6. Bore hole dia. <u>9</u> in. Completion date <u>6-8-1978</u> Well depth <u>70</u> ft.		
5. Type and color of material			7. <input checked="" type="checkbox"/> Cable tool <input checked="" type="checkbox"/> Rotary <input type="checkbox"/> Driven <input type="checkbox"/> Dug <input type="checkbox"/> Hollow rod <input type="checkbox"/> Jetted <input type="checkbox"/> Bored <input type="checkbox"/> Reverse rotary		
			8. Use: <input type="checkbox"/> Domestic <input type="checkbox"/> Public supply <input type="checkbox"/> Industry <input type="checkbox"/> Irrigation <input type="checkbox"/> Air conditioning <input checked="" type="checkbox"/> Stock <input type="checkbox"/> Lawn <input type="checkbox"/> Oil field water <input type="checkbox"/> Other		
			9. Casing: Material <u>Plastic</u> Height: Above or below Threaded <input type="checkbox"/> Welded <input checked="" type="checkbox"/> glue Surface <u>1 1/2</u> in. RMP <input checked="" type="checkbox"/> PVC <input type="checkbox"/> Weight <u>1.8</u> lbs./ft. Dia. <u>5</u> in. to <u>50</u> ft. depth Wall Thickness: inches or Dia. <u>5</u> in. to <u>50</u> ft. depth gage No. <u>.250</u>		
			10. Screen: Manufacturer's name <u>Jess & Lowell</u> Type <u>RMP</u> Dia. <u>5"</u> Slot/gauze <u>1/16"</u> Length <u>20'</u> Set between <u>50</u> ft. and <u>70</u> ft. Gravel pack? <input checked="" type="checkbox"/> yes Size range of material <u>1/4x1/8"</u>		
			11. Static water level: <u>27</u> ft. below land surface Date <u>6-7-1978</u> mo./day/yr.		
			12. Pumping level below land surfaces: <u>30</u> ft. after <u>1</u> hrs. pumping <u>4</u> g.p.m. <u> </u> ft. after <u> </u> hrs. pumping <u> </u> g.p.m. Estimated maximum yield <u>4</u> g.p.m.		
			13. Water sample submitted: <u> </u> mo./day/yr. <input type="checkbox"/> Yes <input checked="" type="checkbox"/> No Date <u> </u>		
			14. Well head completion: <input type="checkbox"/> Pitless adapter <u>12</u> Inches above grade		
			15. Well grouted? <input checked="" type="checkbox"/> yes With: <input checked="" type="checkbox"/> Neat cement <input type="checkbox"/> Bentonite <input type="checkbox"/> Concrete Depth: From <u>0</u> ft. to <u>15</u> ft.		
			16. Nearest source of possible contamination: ft. <u>2700</u> Direction <u>N</u> Type <u>Farmstead</u> Well disinfected upon completion? <input checked="" type="checkbox"/> Yes <input type="checkbox"/> No		
			17. Pump: <input type="checkbox"/> Not installed Manufacturer's name <u>Dempster windmill</u> Model number <u> </u> HP <u> </u> Volts <u> </u> Length of drop pipe <u>65</u> ft. capacity <u>4</u> g.p.m. Type: <input type="checkbox"/> Submersible <input type="checkbox"/> Turbine <input type="checkbox"/> Jet <input type="checkbox"/> Reciprocating <input type="checkbox"/> Centrifugal <u>cylinder</u> Other		
18. Elevation:			20. Water well contractor's certification: This well was drilled under my jurisdiction and this report is true to the best of my knowledge and belief. Weishaar Drilling & Supply 232 Business name License No. <u> </u> Address <u>Scott City, KS 67871</u> Signed <u> </u> Date <u>6-14-78</u> Authorized representative		
19. Remarks: Topography: <input type="checkbox"/> Hill <input type="checkbox"/> Slope <input type="checkbox"/> Upland <input checked="" type="checkbox"/> Valley					

Forward the white, blue and pink copies to the Department of Health and Environment

Form WWC-5