


LOCATION OF WATER WELL: Fraction SE 1/4 NW 1/4 SW 1/4 Section Number 33 Township Number T 17 S Range Number R 28 E/W

Distance and direction from nearest town or city street address of well if located within city?
 3 north 2 east of Dighton

WATER WELL OWNER: Mr. Hutchins Da Mac Drilling
 RR#, St. Address, Box #: Dighton, Ks. Box 1164
 City, State, ZIP Code: Great Bend, Ks. 67530
 Board of Agriculture, Division of Water Resources Application Number: T84-77

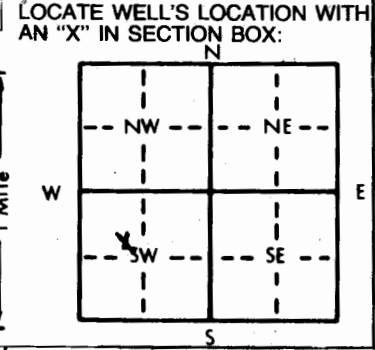

DEPTH OF COMPLETED WELL... 125 ft. ELEVATION: ...
 Depth(s) Groundwater Encountered 1. 2.7 ft. 2. ft. 3. ft.
 WELL'S STATIC WATER LEVEL ... 80 ft. below land surface measured on mo/day/yr 2-8-84
 Pump test data: Well water was ... ft. after ... hours pumping ... gpm
 Est. Yield ... NA ... gpm: Well water was ... ft. after ... hours pumping ... gpm
 Bore Hole Diameter ... 1.0 in. to ... 12.5 ft., and ... in. to ... ft.
 WELL WATER TO BE USED AS:
 5 Public water supply 8 Air conditioning 11 Injection well
 1 Domestic 3 Feedlot 6 Oil field water supply 9 Dewatering 12 Other (Specify below)
 2 Irrigation 4 Industrial 7 Lawn and garden only 10 Observation well
 Was a chemical/bacteriological sample submitted to Department? Yes ... No ... X ...; If yes, mo/day/yr sample was submitted
 Water Well Disinfected? Yes HTH No

TYPE OF BLANK CASING USED:
 1 Steel 3 RMP (SR) 5 Wrought iron 8 Concrete tile CASING JOINTS: Glued X Clamped
 2 PVC 4 ABS 6 Asbestos-Cement 9 Other (specify below) Welded
 7 Fiberglass Threaded
 Blank casing diameter ... 5 in. to ... 8.5 ft., Dia ... in. to ... ft., Dia ... in. to ... ft.
 Casing height above land surface ... 18 in., weight ... lbs./ft. Wall thickness or gauge No. 2.58

TYPE OF SCREEN OR PERFORATION MATERIAL:
 1 Steel 3 Stainless steel 5 Fiberglass 7 PVC 10 Asbestos-cement
 2 Brass 4 Galvanized steel 6 Concrete tile 8 RMP (SR) 11 Other (specify)
 9 ABS 12 None used (open hole)

SCREEN OR PERFORATION OPENINGS ARE:
 1 Continuous slot 3 Mill slot 5 Gauzed wrapped 8 Saw cut 11 None (open hole)
 2 Louvered shutter 4 Key punched 6 Wire wrapped 9 Drilled holes
 7 Torch cut 10 Other (specify)

SCREEN-PERFORATED INTERVALS: From ... 85 ft. to ... 125 ft., From ... ft. to ... ft.
 GRAVEL PACK INTERVALS: From ... 10 ft. to ... 125 ft., From ... ft. to ... ft.

GROUT MATERIAL: 1 Neat cement 2 Cement grout 3 Bentonite 4 Other
 Grout Intervals: From ... 0 ft. to ... 10 ft., From ... ft. to ... ft., From ... ft. to ... ft.

What is the nearest source of possible contamination:
 1 Septic tank 4 Lateral lines 7 Pit privy 10 Livestock pens 14 Abandoned water well
 2 Sewer lines 5 Cess pool 8 Sewage lagoon 11 Fuel storage 15 Oil well/Gas well
 3 Watertight sewer lines 6 Seepage pit 9 Feedyard 12 Fertilizer storage 16 Other (specify below)
 13 Insecticide storage

Direction from well? west How many feet? 80

FROM	TO	LITHOLOGIC LOG	FROM	TO	LITHOLOGIC LOG
0	27	30 Clay & rock layers			
27	34	05 Sand			
34	39	01 Clay			
39	66	04 Clay layers and sand			
66	78	05 Sand			
78	110	29 Course sand & rock layers			
110	125	21 Clay, rock & shale			

CONTRACTOR'S OR LANDOWNER'S CERTIFICATION: This water well was (1) constructed, (2) reconstructed, or (3) plugged under my jurisdiction and was completed on (mo/day/year) 2-8-84 and this record is true to the best of my knowledge and belief. Kansas Water Well Contractor's License No. 134 This Water Well Record was completed on (mo/day/yr) 3-1-84
 Under the business name of Rosencrantz-Bemis Ent. by (signature) Lora Dodson

INSTRUCTIONS: Use typewriter or ball point pen, PLEASE PRESS FIRMLY and PRINT clearly. Please fill in blanks, underline or circle the correct answers. Send top three copies to Kansas Department of Health and Environment, Division of Environment, Environmental Geology Section, Topeka, KS 66620. Send one to WATER WELL OWNER and retain one for your records.

OFFICE USE ONLY T 17 R 28 E/W SEC. 33 SE 1/4 NW 1/4 SW 1/4

DP