


1 LOCATION OF WATER WELL: Fraction **NW 1/4 SW 1/4 SW 1/4** Section Number **31** Township Number **T 17 S** Range Number **R 28 EW**
 County: **Lane**
 Distance and direction from nearest town or city street address of well if located within city?
Gerald # 1-31

2 WATER WELL OWNER: **Gerald Riley**
 RR#, St. Address, Box # : **P. O. Box 937** Board of Agriculture, Division of Water Resources
 City, State, ZIP Code : **Dighton, Ks 67839** Application Number: **20070113**

3 LOCATE WELL'S LOCATION WITH AN "X" IN SECTION BOX:

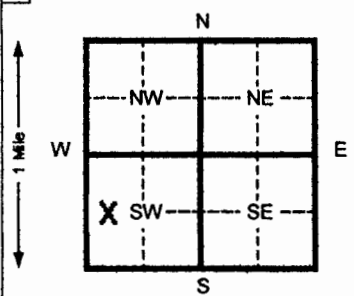

4 DEPTH OF COMPLETED WELL **110** ft. ELEVATION: _____
 Depth(s) Groundwater Encountered 1 _____ ft. 2 _____ ft. 3 _____ ft.
 WELL'S STATIC WATER LEVEL **na** ft. below land surface measured on mo/day/yr _____
 Pump test data: Well water was _____ ft. after _____ hours pumping _____ gpm
 Est. Yield _____ gpm: Well water was _____ ft. after _____ hours pumping _____ gpm
 Bore Hole Diameter **8** in. to **110** ft. and _____ in. to _____ ft.
 WELL WATER TO BE USED AS: Public water supply Air conditioning Injection well
 Domestic Feed lot Oil field water supply Dewatering Other (Specify below)
 Irrigation Industrial Lawn and garden (domestic) Monitoring well
 Was a chemical/bacteriological sample submitted to Department? Yes _____ No If yes, mo/day/yr sample was submitted _____
 Water Well Disinfected? Yes No _____

5 TYPE OF BLANK CASING USED:
 Steel RMP (SR) Wrought Iron Concrete tile CASING JOINTS: Glued Clamped
 PVC ABS Asbestos-Cement Other (specify below) Welded _____
 Fiberglass Threaded _____
 Blank casing diameter **4.5** in. to **70** ft., Dia _____ in. to _____ ft., Dia _____ in. to _____ ft.
 Casing height above land surface **18** in., weight **2.38** lbs./ft. Wall thickness or gauge No. **.248**
 TYPE OF SCREEN OR PERFORATION MATERIAL:
 Steel Stainless steel Fiberglass RMP (SR) Asbestos-cement
 Brass Galvanized steel Concrete tile ABS Other (specify) _____
 None used (open hole)
 SCREEN OR PERFORATION OPENINGS ARE:
 Continuous slot Mill slot Gauzed wrapped Saw cut None (open hole)
 Louvered shutter Key punched Wire wrapped Drilled holes
 Torch cut Other (specify) _____
 SCREEN-PERFORATED INTERVALS: From **70** ft. to **110** ft. From _____ ft. to _____ ft.
 From _____ ft. to _____ ft. From _____ ft. to _____ ft.
 GRAVEL PACK INTERVALS: From **20** ft. to **110** ft. From _____ ft. to _____ ft.
 From _____ ft. to _____ ft. From _____ ft. to _____ ft.

8 GROUT MATERIAL: Neat cement Cement grout Bentonite Other _____
 Grout Intervals From **0** ft. to **20** ft. From _____ ft. to _____ ft. From _____ ft. to _____ ft.
 What is the nearest source of possible contamination:
 Septic tank Lateral lines Pit privy Livestock pens Abandoned water well
 Sewer lines Cess pool Sewage lagoon Fuel storage Oil well/ Gas well
 Watertight sewer lines Seepage pit Feedyard Fertilizer storage Other (specify below)
 Insecticide storage **none**

Direction from well? _____ How many feet? _____

FROM	TO	CODE	LITHOLOGIC LOG	FROM	TO	PLUGGING INTERVALS
0	2		Surface	96	110	Yellow ochre/grey shale
2	16		Loess			
16	20		Fine to med sd w/caliche strks			
20	30		Fine sand w/caliche lenses			
30	45		Fine to med sand w/ sandstone Strks			
45	50		Fine to med sand w/sandstone Lenses			
50	60		Fine to med sand w/caliche strk			
60	75		Fine to med sd w/caliche lenses			
75	80		Fine to med sand w/clay & Caliche strks			
80	96		Fine to med sand w/sandstone strks			

7 CONTRACTOR'S OR LANDOWNER'S CERTIFICATION: This water well was (1) constructed, (2) reconstructed, or (3) plugged under my jurisdiction and was completed on (mo/day/yr) **3-30-07** and this record is true to the best of my knowledge and belief. Kansas
 Water Well Contractor's License No. **554** This Water Well Record was completed on (mo/day/yr) **4-06-07**
 under the business name of **Woofer Pump & Well Inc.** by (signature) *John C. Woofer, Jr. MR*

OFFICE USE ONLY

T

R

SEC