

WATER WELL RECORD Form WWC-5


Original Record Correction Change in Well Use

Division of Water Resources App. No.

Well ID

1 LOCATION OF WATER WELL: County: Lane Fraction: SW 1/4 NW 1/4 SW 1/4 SE 1/4 Section Number: 35 Township Number: T17 S Range Number: R28 E 1W

2 WELL OWNER: Last Name: Linden First: Maurice Street or Rural Address where well is located (if unknown, distance and direction from nearest town or intersection): If at owner's address, check here:
 Business: 140 N Fourth Address: Dighton State: Ks ZIP: 67839 5 miles East of Dighton + 3 miles North

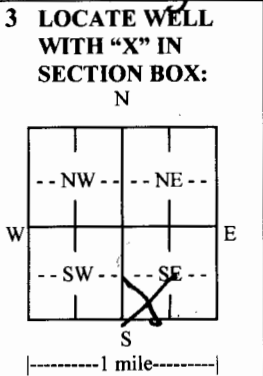

4 DEPTH OF COMPLETED WELL: Depth(s) Groundwater Encountered: 1) 39 ft. 2) 48 ft. 3) 48 ft. or 4) Dry Well
 WELL'S STATIC WATER LEVEL: 9 ft. below land surface, measured on (mo-day-yr) 11-24-12
 above land surface, measured on (mo-day-yr).....
 Pump test data: Well water was 3 ft. after 2 hours pumping 2 gpm
 Well water was 3 ft. after 2 hours pumping 2 gpm
 Estimated Yield: 2 gpm
 Bore Hole Diameter: 8 in. to 48 ft. and 48 in. to 48 ft.

5 Latitude: N 38.52902 (decimal degrees)
Longitude: W 100.38169 (decimal degrees)
 Datum: WGS 84 NAD 83 NAD 27
 Source for Latitude/Longitude:
 GPS (unit make/model:)
 (WAAS enabled? Yes No)
 Land Survey Topographic Map
 Online Mapper: Terra Server

6 Elevation:ft. Ground Level TOC
 Source: Land Survey GPS Topographic Map
 Other

7 WELL WATER TO BE USED AS:

| | | | | | | | | | | | | |
|---|--|-------------------------------------|--|--|---|---|---|---|--|------------------------------|---------------------------------------|---|
| 1. Domestic: <input type="checkbox"/> Household <input type="checkbox"/> Lawn & Garden <input checked="" type="checkbox"/> Livestock | 2. <input type="checkbox"/> Irrigation | 3. <input type="checkbox"/> Feedlot | 4. <input type="checkbox"/> Industrial | 5. <input type="checkbox"/> Public Water Supply: well ID | 6. <input type="checkbox"/> Dewatering: how many wells? | 7. <input type="checkbox"/> Aquifer Recharge: well ID | 8. <input type="checkbox"/> Monitoring: well ID | 9. Environmental Remediation: well ID | 10. <input type="checkbox"/> Oil Field Water Supply: lease | 11. Test Hole: well ID | 12. Geothermal: how many bores? | 13. <input type="checkbox"/> Other (specify): |
|---|--|-------------------------------------|--|--|---|---|---|---|--|------------------------------|---------------------------------------|---|

Was a chemical/bacteriological sample submitted to KDHE? Yes No If yes, date sample was submitted:

8 TYPE OF CASING USED: Steel PVC Other CASING JOINTS: Glued Clamped Welded Threaded
 Casing diameter 5 in. to 48 ft., Diameter in. to ft., Diameter in. to ft.
 Casing height above land surface 24 in. Weight 5 lbs./ft. Wall thickness or gauge No. Sch 40

TYPE OF SCREEN OR PERFORATION MATERIAL:
 Steel Stainless Steel Fiberglass PVC Other (Specify)
 Brass Galvanized Steel Concrete tile None used (open hole)

SCREEN OR PERFORATION OPENINGS ARE:
 Continuous Slot Mill Slot Gauze Wrapped Torch Cut Drilled Holes Other (Specify)
 Louvered Shutter Key Punched Wire Wrapped Saw Cut None (Open Hole)

SCREEN-PERFORATED INTERVALS: From 28 ft. to 48 ft., From ft. to ft., From ft. to ft.
 GRAVEL PACK INTERVALS: From 28 ft. to 48 ft., From ft. to ft., From ft. to ft.

9 GROUT MATERIAL: Neat cement Cement grout Bentonite Other
 Grout Intervals: From 0 ft. to 20 ft., From 20 ft. to 28 ft., From 28 ft. to 48 ft., From ft. to ft.

Nearest source of possible contamination:
 Septic Tank Lateral Lines Pit Privy Livestock Pens Insecticide Storage
 Sewer Lines Cess Pool Sewage Lagoon Fuel Storage Abandoned Water Well
 Watertight Sewer Lines Seepage Pit Feedyard Fertilizer Storage Oil Well/Gas Well
 Other (Specify) None
 Direction from well? Distance from well? ft.

| 10 FROM | TO | LITHOLOGIC LOG | FROM | TO | LITHO. LOG (cont.) or PLUGGING INTERVALS |
|---------|----|--------------------------------|------|----|--|
| 0 | 3 | Top Soil | | | |
| 3 | 11 | yellow clay | | | |
| 11 | 16 | fine sand | | | |
| 16 | 28 | yellow clay | | | |
| 28 | 44 | dark yellow clay | | | |
| 44 | 46 | dark yellow + little fine sand | | | |
| 46 | 48 | shale | | | |

Notes:

11 CONTRACTOR'S OR LANDOWNER'S CERTIFICATION: This water well was constructed, reconstructed, or plugged under my jurisdiction and was completed on (mo-day-year) 11-24-12 and this record is true to the best of my knowledge and belief.
 Kansas Water Well Contractor's License No. 827 This Water Well Record was completed on (mo-day-year) 12-21-12 under the business name of Excel Windmill Repair