

1 LOCATION OF WATER WELL
 County: Jane Fraction NE $\frac{1}{4}$ SE $\frac{1}{4}$ SE $\frac{1}{4}$ Section Number 5 Township Number T 17 S Range Number R 29 EW
 Distance and direction from nearest town or city? 4 miles East
 $\frac{1}{4}$ North of Healy, Kansas Street address of well if located within city?

2 WATER WELL OWNER: Larry Munsell
 RR#, St. Address, Box # :
 City, State, ZIP Code : Healy, Kansas 67850
 Board of Agriculture, Division of Water Resources
 Application Number:

3 DEPTH OF COMPLETED WELL... 167 ft. Bore Hole Diameter... 9 in. to 167 ft., and ... in. to ... ft.
 Well Water to be used as:
 1 Domestic 3 Feedlot 5 Public water supply 8 Air conditioning 11 Injection well
 2 Irrigation 4 Industrial 6 Oil field water supply 9 Dewatering 12 Other (Specify below)
Stockwell
 Well's static water level ... 112 ft. below land surface measured on ... 12 month ... 13 day 1979 year
 Pump Test Data : Well water was ... 113 ft. after 4 hours pumping ... 4 gpm
 Est. Yield 50 gpm: Well water was ... ft. after ... hours pumping ... gpm


4 TYPE OF BLANK CASING USED:
 1 Steel 3 RMP (SR) 5 Wrought iron 8 Concrete tile Casing Joints: Glued Clamped
 2 PVC 4 ABS 6 Asbestos-Cement 9 Other (specify below) Welded
 7 Fiberglass Threaded
 Blank casing dia ... 5 in. to 147 ft. Dia ... in. to ... ft. Dia ... in. to ... ft.
 Casing height above land surface ... 12 in., weight 1.8 lbs./ft. Wall thickness or gauge No. 250

TYPE OF SCREEN OR PERFORATION MATERIAL:
 1 Steel 3 Stainless steel 5 Fiberglass 8 RMP (SR) 10 Asbestos-cement
 2 Brass 4 Galvanized steel 6 Concrete tile 9 ABS 11 Other (specify)
 12 None used (open hole)
 Screen or Perforation Openings Are:
 1 Continuous slot 3 Mill slot 5 Gauzed wrapped 8 Saw cut 11 None (open hole)
 2 Louvered shutter 4 Key punched 6 Wire wrapped 9 Drilled holes
 7 Torch cut 10 Other (specify)
 Screen-Perforation Dia ... 5 in. to 167 ft. Dia ... in. to ... ft. Dia ... in. to ... ft.
 Screen-Perforated Intervals: From ... 147 ft. to 167 ft. From ... ft. to ... ft.
 Gravel Pack Intervals: From ... 15 ft. to 130 ft. From ... ft. to ... ft.

5 GROUT MATERIAL: 1 Neat cement 2 Cement grout 3 Bentonite 4 Other Drill cuttings
 Grouted Intervals: From ... 15 ft. to 130 ft. From ... 0 ft. to 15 ft. From ... ft. to ... ft.

What is the nearest source of possible contamination:
1 Septic tank 4 Cess pool 7 Sewage lagoon 10 Fuel storage 14 Abandoned water well
 2 Sewer lines 5 Seepage pit 8 Feed yard 11 Fertilizer storage 15 Oil well/Gas well
 3 Lateral lines 6 Pit privy 9 Livestock pens 12 Insecticide storage 16 Other (specify below)
 13 Watertight sewer lines
 Direction from well ... South How many feet ... 1320 ? Water Well Disinfected? Yes No
 Was a chemical/bacteriological sample submitted to Department? Yes No If yes, date sample
 was submitted ... month ... day ... year Pump Installed? Yes No
 Yes: Pump Manufacturer's name ... Cylinder Model No. Windmill HP ... Volts
 Depth of Pump Intake ... 140 ft. Pumps Capacity rated at ... 4 gal./min.
 Type of pump: 1 Submersible 2 Turbine 3 Jet 4 Centrifugal 5 Reciprocating 6 Other

CONTRACTOR'S OR LANDOWNER'S CERTIFICATION: This water well was (1) constructed, (2) reconstructed, or (3) plugged under my jurisdiction and was
 completed on ... 12 month ... 14 day ... 1979 year
 and this record is true to the best of my knowledge and belief. Kansas Water Well Contractor's License No. 232
 This Water Well Record was completed on ... 12 month ... 17 day ... 1979 year under the business
 name of Weishaar Drilling & Supply Inc. by (signature) Boyd Stanton

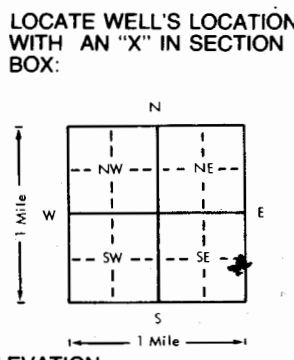

FROM	TO	LITHOLOGIC LOG	FROM	TO	LITHOLOGIC LOG
0	17	Clay	17	30	Gyp
30	40	Sand & gravel	40	45	Clay
45	92	Fine sand	92	99	Sand cemented
99	120	Fine sand	120	130	Sand
130	132	Rock	132	147	Sand
147	153	Fine sand	153	165	Sand & gravel
165	167	Yellow clay			

ELEVATION:
 Depth(s) Groundwater Encountered 1. 112 ft. 2. ... ft. 3. ... ft. 4. ... ft. (Use a second sheet if needed)

INSTRUCTIONS: Use typewriter or ball point pen, please press firmly and PRINT clearly. Please fill in blanks, underline or circle the correct answers. Send top three copies to Kansas Department of Health and Environment, Division of Environment, Water Well Contractors, Topeka, KS 66620. Send one to WATER WELL OWNER and retain one for your records.

OFFICE USE ONLY
T
17
R
29
EW
SEC
5
NE 1/4 SE 1/4 SE 1/4