


1 LOCATION OF WATER WELL: County: Lane Fraction SE 1/4 SW 1/4 NE 1/4 Section Number 6 Township Number T 17 S Range Number R 29 EW

Distance and direction from nearest town or city street address of well if located within city?  
 2 3/4 east of Healy

2 WATER WELL OWNER: Bill Direen Slawson Drilling  
 RR#, St. Address, Box #: Hoisington, Ks. Box 1409 Board of Agriculture, Division of Water Resources  
 City, State, ZIP Code: Great Bend, Ks. 67530 Application Number: T84-41

3 LOCATE WELL'S LOCATION WITH AN "X" IN SECTION BOX:

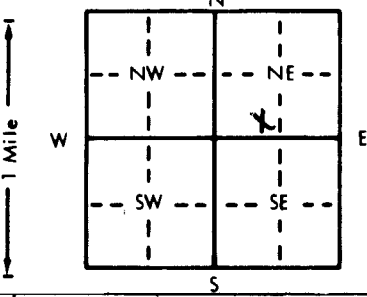

4 DEPTH OF COMPLETED WELL: 140 ft. ELEVATION:  
 Depth(s) Groundwater Encountered 1. 4.8 ft. 2. ft. 3. ft.  
 WELL'S STATIC WATER LEVEL 110 ft. below land surface measured on mo/day/yr 1-20-84  
 Pump test data: Well water was ft. after hours pumping gpm  
 Est. Yield NA gpm: Well water was ft. after hours pumping gpm  
 Bore Hole Diameter 10 in. to 140 ft., and in. to ft.  
 WELL WATER TO BE USED AS:  
 5 Public water supply 8 Air conditioning 11 Injection well  
 1 Domestic 3 Feedlot 6 Oil field water supply 9 Dewatering 12 Other (Specify below)  
 2 Irrigation 4 Industrial 7 Lawn and garden only 10 Observation well  
 Was a chemical/bacteriological sample submitted to Department? Yes No X; If yes, mo/day/yr sample was submitted  
 Water Well Disinfected? Yes HTH No

5 TYPE OF BLANK CASING USED:  
 1 Steel 3 RMP (SR) 5 Wrought iron 8 Concrete tile CASING JOINTS: Glued X Clamped  
 2 PVC 4 ABS 6 Asbestos-Cement 9 Other (specify below) Welded  
 7 Fiberglass Threaded

Blank casing diameter 5 in. to 120 ft., Dia. in. to ft., Dia. in. to ft.  
 Casing height above land surface 18 in., weight lbs./ft. Wall thickness or gauge No. 258

TYPE OF SCREEN OR PERFORATION MATERIAL:  
 1 Steel 3 Stainless steel 5 Fiberglass 7 PVC 10 Asbestos-cement  
 2 Brass 4 Galvanized steel 6 Concrete tile 8 RMP (SR) 11 Other (specify)  
 9 ABS 12 None used (open hole)

SCREEN OR PERFORATION OPENINGS ARE:  
 1 Continuous slot 3 Mill slot 5 Gauzed wrapped 8 Saw cut 11 None (open hole)  
 2 Louvered shutter 4 Key punched 6 Wire wrapped 9 Drilled holes  
 7 Torch cut 10 Other (specify)

SCREEN-PERFORATED INTERVALS: From 120 ft. to 140 ft., From ft. to ft.  
 GRAVEL PACK INTERVALS: From 10 ft. to 140 ft., From ft. to ft.

6 GROUT MATERIAL: 1 Neat cement 2 Cement grout 3 Bentonite 4 Other  
 Grout Intervals: From 0 ft. to 10 ft., From ft. to ft., From ft. to ft.

What is the nearest source of possible contamination:  
 1 Septic tank 4 Lateral lines 7 Pit privy 10 Livestock pens 14 Abandoned water well  
 2 Sewer lines 5 Cess pool 8 Sewage lagoon 11 Fuel storage 15 Oil well/Gas well  
 3 Watertight sewer lines 6 Seepage pit 9 Feedyard 12 Fertilizer storage 16 Other (specify below)  
 13 Insecticide storage  
 Direction from well? west How many feet? 80

| FROM | TO  | LITHOLOGIC LOG                                   | FROM | TO | LITHOLOGIC LOG |
|------|-----|--|------|----|----------------|
| 0    | 2   | Dark top soil                                    |      |    |                |
| 2    | 17  | Tan clay   |      |    |                |
| 17   | 48  | White broken rock w/streaks of tan sandy clay    |      |    |                |
| 48   | 57  | Sand   |      |    |                |
| 57   | 94  | Tan sandy clay w/white broken rock               |      |    |                |
| 94   | 133 | Sand and gravel w/thin streaks of tan sandy clay |      |    |                |
| 133  | 140 | Tan sandy clay                                   |      |    |                |

7 CONTRACTOR'S OR LANDOWNER'S CERTIFICATION: This water well was (1) constructed, (2) reconstructed, or (3) plugged under my jurisdiction and was completed on (mo/day/year) 1-20-84 and this record is true to the best of my knowledge and belief. Kansas Water Well Contractor's License No. 134. This Water Well Record was completed on (mo/day/yr) 2-23-84 under the business name of Rosencrantz-Bemis Ent. by (signature) Doris Dodson

INSTRUCTIONS: Use typewriter or ball point pen, PLEASE PRESS FIRMLY and PRINT clearly. Please fill in blanks, underline or circle the correct answers. Send top three copies to Kansas Department of Health and Environment, Division of Environment, Environmental Geology Section, Topeka, KS 66620. Send one to WATER WELL OWNER and retain one for your records.

OFFICE USE ONLY T 17 R 29 E/W SEC. 6 SE 1/4 SW 1/4 NE 1/4

DD