

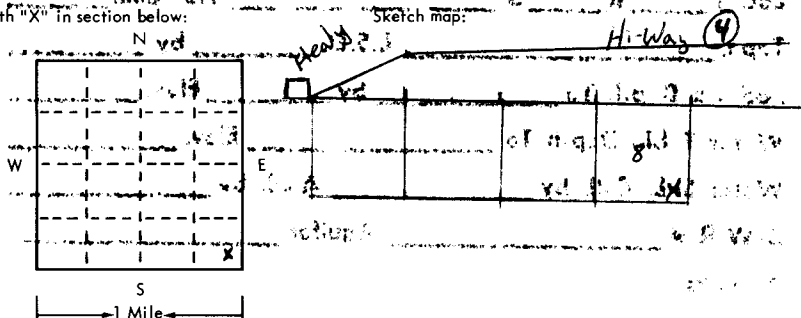
USE TYPEWRITER OR BALL POINT PEN-PRESS FIRMLY, PRINT CLEARLY.

T R EW sec 1/4 1/4 1/4 No.

WATER WELL RECORD
KSA 82a-1201-1215

Kansas State Dept. Of Health
(Water Well Contractors)
Forbes-Bldg. 740
Topeka, Kansas 66620

SE 1/4 SE 1/4 SE 1/4

1 Location of well:	County Lane	Township name Cheyenne	Fraction SE 1/4	Section number 8	Town number 17	Range number 29 W
Distance and direction from nearest town or city: 4 E 1 S of			3 Owner of well: L.O. Shay			
Street address of well location if in city: Healy, Ks			Address: Healy, Kansas			
Locate with "X" in section below: 			4 Well depth: 177 ft. Date of completion 4-23-76 Well diameter 12 in.			
			5 <input type="checkbox"/> Cable tool <input checked="" type="checkbox"/> Rotary <input type="checkbox"/> Driven <input type="checkbox"/> Dug <input type="checkbox"/> Hollow rod <input type="checkbox"/> Jetted <input type="checkbox"/> Bored <input type="checkbox"/> Reverse rotary			
			6 Use: <input type="checkbox"/> Domestic <input type="checkbox"/> Public supply <input type="checkbox"/> Industry <input checked="" type="checkbox"/> Irrigation <input type="checkbox"/> Air conditioning <input type="checkbox"/> Commercial <input type="checkbox"/> Test well <input type="checkbox"/>			
			7 Casing: Material Steel Height: above/below Threaded <input type="checkbox"/> Welded <input checked="" type="checkbox"/> Surface 12 in. Diam. 12 in. to 137 ft. depth Drive shoe? <input type="checkbox"/> Yes <input checked="" type="checkbox"/> No Weight 137 lbs./ft. 12 in. to 137 ft. depth			
2 Type and color of material			Fram		To	
Soil			0		10	
Gyp + clay			10		25	
Sandy clay			25		42	
Sand			42		56	
clay			56		74	
Sandy clay			74		95	
Sand			95		102	
clay			102		114	
Sand			114		125	
clay			125		129	
Sand			129		131	
clay			131		138	
Sand			138		146	
clay			146		157	
Sand			157		162	
clay			162		165	
Sand			165		172	
Yellow			172		177	
Blue shale (use a second sheet if needed)			177			
16 Remarks: elevation Tapography: <input type="checkbox"/> Hill <input type="checkbox"/> Slope <input type="checkbox"/> Upland <input type="checkbox"/> Valley			8 Screen: Manufacturer WA Brown Type _____ Dia. 12 Slot/gauze _____ Length 40 Set between 137 ft. and 177 ft. Fittings: _____ Gravel pack <input checked="" type="checkbox"/> Yes <input type="checkbox"/> No Size range of material 1/4 - 5/8			
			9 Static water level: 121 ft. below land surface Date _____			
			10 Pumping level below land surfaces: _____ ft. after _____ hrs. pumping _____ g.p.m. _____ ft. after _____ hrs. pumping _____ g.p.m. Estimated maximum yield 400 g.p.m.			
			11 Water sample submitted: <input type="checkbox"/> Yes <input checked="" type="checkbox"/> No Date _____			
			12 Well head completion: <input type="checkbox"/> Pitless adapter <input type="checkbox"/> Inches above grade			
			13 Well grouted? <input checked="" type="checkbox"/> Yes <input type="checkbox"/> No <input checked="" type="checkbox"/> Neat cement <input type="checkbox"/> Bentonite <input type="checkbox"/> _____ Depth: From 0 ft. to 10 ft.			
			14 Nearest source of possible contamination: ft. _____ Direction _____ Type _____ Well disinfected upon completion? <input checked="" type="checkbox"/> Yes <input type="checkbox"/> No			
			15 Pump: <input type="checkbox"/> Not installed Manufacturer's name VALLEY Model number DLO HP 30 Volts _____ Length of drop pipe 170 ft. capacity _____ g.m.p. Type: <input type="checkbox"/> Submersible <input checked="" type="checkbox"/> Turbine <input type="checkbox"/> Jet <input type="checkbox"/> Reciprocating <input type="checkbox"/> Centrifugal <input type="checkbox"/> Other			
17 Water well contractor's certification: This well was drilled under my jurisdiction and this report is true to the best of my knowledge and belief. Whinery Drilling 256 Business name _____ License No. _____ Address 405 Antelope STOTT, Ks Signed John Whinery Date 2-24-80 Authorized representative						

17 29W 8 SESESE