


1 LOCATION OF WATER WELL: County: Lane Fraction: SW 1/4 NE 1/4 NW 1/4 Section Number: 10 Township Number: T 17 S Range Number: R 29 EW

Distance and direction from nearest town or city street address of well if located within city?
 From Dighton - 6 1/2 Miles North, 2 Miles West, 3985 Ft. North & 3825 Ft. West.

2 WATER WELL OWNER: Lane County Feeders
 RR#, St. Address, Box #: P. O. Box 607
 City, State, ZIP Code: Dighton, Kansas 67839
 Board of Agriculture, Division of Water Resources
 Application Number: 38678

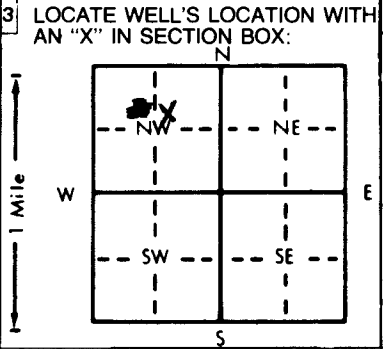

4 DEPTH OF COMPLETED WELL: 170 ft. ELEVATION: _____ ft.
 Depth(s) Groundwater Encountered: 1 ft. 2. _____ ft. 3. 10-24-89 ft.
 WELL'S STATIC WATER LEVEL: 119 ft. below land surface measured on mo/day/yr
 Pump test data: Well water was _____ ft. after _____ hours pumping _____ gpm
 Est. Yield _____ gpm: Well water was _____ ft. after _____ hours pumping _____ gpm
 Bore Hole Diameter: 30 in. to 170 ft., and _____ in. to _____ ft.
 WELL WATER TO BE USED AS:
 5 Public water supply 8 Air conditioning 11 Injection well
 1 Domestic 3 Feedlot 6 Oil field water supply 9 Dewatering 12 Other (Specify below)
 Irrigation 4 Industrial 7 Lawn and garden only 10 Monitoring well
 Was a chemical/bacteriological sample submitted to Department? Yes _____ No ; If yes, mo/day/yr sample was submitted _____
 Water Well Disinfected? Yes _____ No

5 TYPE OF BLANK CASING USED:
 Steel 3 RMP (SR) 6 Asbestos-Cement 9 Other (specify below) Welded XX
 2 PVC 4 ABS 7 Fiberglass Threaded _____
 Blank casing diameter: 16 in. to 125 ft., Dia _____ in. to _____ ft., Dia _____ in. to _____ ft.
 Casing height above land surface: 12 in., weight 42.05 lbs./ft. Wall thickness or gauge No. 250
 TYPE OF SCREEN OR PERFORATION MATERIAL:
 Steel 3 Stainless steel 5 Fiberglass 8 RMP (SR) 11 Other (specify) _____
 2 Brass Galvanized steel 6 Concrete tile 9 ABS 12 None used (open hole)
 SCREEN OR PERFORATION OPENINGS ARE:
 1 Continuous slot Mill slot Wire wrapped 8 Saw cut 11 None (open hole)
 2 Louvered shutter 4 Key punched 7 Torch cut 9 Drilled holes 10 Other (specify) _____
 SCREEN-PERFORATED INTERVALS: From 125 ft. to 170 ft., From _____ ft. to _____ ft.
 From _____ ft. to _____ ft., From _____ ft. to _____ ft.
 GRAVEL PACK INTERVALS: From 20 ft. to 170 ft., From _____ ft. to _____ ft.
 From _____ ft. to _____ ft., From _____ ft. to _____ ft.

6 GROUT MATERIAL: 1 Neat cement Cement grout 3 Bentonite 4 Other _____
 Grout Intervals: From 0 ft. to 20 ft., From _____ ft. to _____ ft., From _____ ft. to _____ ft.
 What is the nearest source of possible contamination:
 1 Septic tank 4 Lateral lines 7 Pit privy 10 Livestock pens 14 Abandoned water well
 2 Sewer lines 5 Cess pool 8 Sewage lagoon 11 Fuel storage 15 Oil well/Gas well
 3 Watertight sewer lines 6 Seepage pit 9 Feedyard 12 Fertilizer storage 16 Other (specify below) N/A
 13 Insecticide storage
 Direction from well? _____ How many feet? _____

FROM	TO	LITHOLOGIC LOG	FROM	TO	PLUGGING INTERVALS
		See attached log			

7 CONTRACTOR'S OR LANDOWNER'S CERTIFICATION: This water well was constructed, (2) reconstructed, or (3) plugged under my jurisdiction and was completed on (mo/day/year) 11-16-89 and this record is true to the best of my knowledge and belief. Kansas Water Well Contractor's License No. 208. This Water Well Record was completed on (mo/day/yr) 12-27-89 under the business name of Minter-Wilson Drilling Co., Inc. by (signature) Nora Keller

OFFICE USE ONLY
T
R
EW
SEC.
1/4
1/4
1/4

*The
Professionals*

MINTER-WILSON DRILLING CO.

INCORPORATED

Irrigation
and Domestic
Water Systems
Complete Installation
and Repairing

Phone 276-8269 • P.O. Box A • GARDEN CITY, KANSAS 67846

Lane County Feeders
Lane County
10-10-89

Location: NW $\frac{1}{4}$ 10-17-29

Static Water Level - _____

Test #2

0	8	Surface
8	19	Clay
19	34	Gypsum
34	46	Tan sandy clay
46	65	Small to medium gravel
65	71	Clay
71	78	Fine to medium sand
78	95	Sand stone - cemented gravel
95	107	Clay with 40% medium gravel
107	125	Fine to medium sand with clay streaks
125	163	Small to medium gravel
163	165	Yellow clay
165	170	Shale

170' T.D. of well