


1 LOCATION OF WATER WELL: Fraction SE 1/4 SE 1/4 SW 1/4 Section Number 23 Township Number T 17 S Range Number R 29 E(W)
 County: Tane

Distance and direction from nearest town or city street address of well if located within city?

5 miles North 1/2 West of Dighton, Kansas

2 WATER WELL OWNER: Mrs George Borell
 RR#, St. Address, Box # : RFD Board of Agriculture, Division of Water Resources
 City, State, ZIP Code : Dighton, Kansas 67839 Application Number:

3 LOCATE WELL'S LOCATION WITH AN "X" IN SECTION BOX:

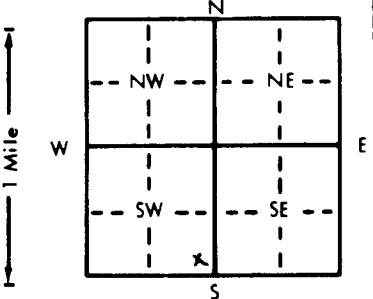

4 DEPTH OF COMPLETED WELL... 152 ft. ELEVATION:
 Depth(s) Groundwater Encountered 1. 82 ft. 2. ft. 3. ft.
 WELL'S STATIC WATER LEVEL 82 ft. below land surface measured on mo/day/yr 12/18/81
 NA Pump test data: Well water was ft. after hours pumping gpm
 Est. Yield gpm: Well water was ft. after hours pumping gpm
 Bore Hole Diameter... 9 in. to 152 ft., and in. to ft.
 WELL WATER TO BE USED AS: 5 Public water supply 8 Air conditioning 11 Injection well
 ① Domestic 3 Feedlot 6 Oil field water supply 9 Dewatering ⑫ Other (Specify below)
 2 Irrigation 4 Industrial 7 Lawn and garden only 10 Observation well Stockwell
 Was a chemical/bacteriological sample submitted to Department? Yes..... No X.....; If yes, mo/day/yr sample was sub-
 mitted Water Well Disinfected? Yes X No

5 TYPE OF BLANK CASING USED: 5 Wrought iron 8 Concrete tile CASING JOINTS Glued Clamped
 1 Steel 3 RMP (SR) 6 Asbestos-Cement 9 Other (specify below) Welded
 ② PVC 4 ABS 7 Fiberglass Threaded.....
 Blank casing diameter 5 in. to 132 ft., Dia in. to ft., Dia in. to ft.
 Casing height above land surface 12 in., weight 2.368 lbs./ft. Wall thickness or gauge No. 214
 TYPE OF SCREEN OR PERFORATION MATERIAL: ⑦ PVC 10 Asbestos-cement
 1 Steel 3 Stainless steel 5 Fiberglass 8 RMP (SR) 11 Other (specify)
 2 Brass 4 Galvanized steel 6 Concrete tile 9 ABS 12 None used (open hole)
 SCREEN OR PERFORATION OPENINGS ARE: 5 Gauzed wrapped ⑧ Saw cut 11 None (open hole)
 1 Continuous slot 3 Mill slot 6 Wire wrapped 9 Drilled holes
 2 Louvered shutter 4 Key punched 7 Torch cut 10 Other (specify)
 SCREEN-PERFORATED INTERVALS: From 132 ft. to 152 ft., From ft. to ft.
 From ft. to ft., From ft. to ft.
 GRAVEL PACK INTERVALS: From 100 ft. to 152 ft., From ft. to ft.
 From ft. to ft., From ft. to ft.

6 GROUT MATERIAL: ① Neat cement 2 Cement grout 3 Bentonite ④ Other Drill Cuttings
 Grout Intervals: From 15 ft. to 100 ft., From 0 ft. to 15 ft., From ft. to ft.
 What is the nearest source of possible contamination: ⑩ Livestock pens 14 Abandoned water well
 1 Septic tank 4 Lateral lines 7 Pit privy 11 Fuel storage 15 Oil well/Gas well
 2 Sewer lines 5 Cess pool 8 Sewage lagoon 12 Fertilizer storage 16 Other (specify below)
 3 Watertight sewer lines 6 Seepage pit 9 Feedyard 13 Insecticide storage
 Direction from well? West How many feet? 200

FROM	TO	LITHOLOGIC LOG	FROM	TO	LITHOLOGIC LOG
0	20	Clay	20	24	Rock
24	42	Gyp	42	47	Clay
47	90	Sand medium	90	97	Sand rock
97	120	Sand medium	120	140	Fine sand
140	144	Sand	144	150	Sand & gravel
150	152	Yellow clay			

7 CONTRACTOR'S OR LANDOWNER'S CERTIFICATION: This water well was ① constructed, ② reconstructed, or ③ plugged under my jurisdiction and was completed on (mo/day/year) 12/21/81 and this record is true to the best of my knowledge and belief. Kansas Water Well Contractor's License No. 232 This Water Well Record was completed on (mo/day/yr) 1/5/82 under the business name of Weishar Drilling & Supply Inc. by (signature) [Signature]

INSTRUCTIONS: Use typewriter or ball point pen, PLEASE PRESS FIRMLY and PRINT clearly. Please fill in blanks, underline or circle the correct answers. Send top three copies to Kansas Department of Health and Environment, Division of Environment, Environmental Geology Section, Topeka, KS 66620. Send one to WATER WELL OWNER and retain one for your records.

OFFICE USE ONLY

T 17

R 29

E(W)

SEC. 23

SE 1/4

SE 1/4

SW 1/4