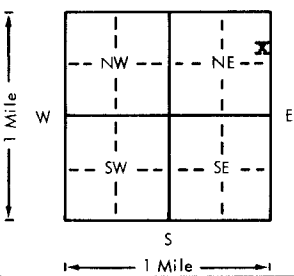
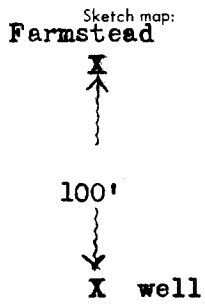


USE TYPEWRITER OR BALL
POINT PEN-PRESS FIRMLY,
PRINT CLEARLY.

WATER WELL RECORD
KSA 82a-1201-1215

Kansas Department of Health and
Environment-Division of Environment
(Water well Contractors)
Topeka, Kansas 66620

1. Location of well:		County Lane	Fraction S/E 1/4 N/E 1/4 N/E 1/4	Section number 31	Township number T 17 S R 29 #/W	Range number
2. Distance and direction from nearest town or city: 1/2 W, 3 N, 3 E, 1 N of Amy, Kansas Street address of well location if in city:				3. Owner of well: Rosen Crenic R.R. or street: Monty Meusch City, state, zip code: Garden City, Kansas 67846		
4. Locate with "X" in section below: 		Sketch map: Farmstead 		6. Bore hole dia. 9 in. Completion date 7/25/1978 Well depth 92 ft.		
5. Type and color of material		From	To	7. <input checked="" type="checkbox"/> Cable tool <input checked="" type="checkbox"/> Rotary <input type="checkbox"/> Driven <input type="checkbox"/> Dug <input type="checkbox"/> Hollow rod <input type="checkbox"/> Jetted <input type="checkbox"/> Bored <input type="checkbox"/> Reverse rotary		
clay		0	21	8. Use: <input type="checkbox"/> Domestic <input type="checkbox"/> Public supply <input type="checkbox"/> Industry <input type="checkbox"/> Irrigation <input type="checkbox"/> Air conditioning <input checked="" type="checkbox"/> Stock <input type="checkbox"/> Lawn <input type="checkbox"/> Oil field water <input type="checkbox"/> Other		
fine sand clay		21	25	9. Casing: Material Plastic Height: Above or below Threaded <input type="checkbox"/> Welded <input checked="" type="checkbox"/> Surface 12 in. RMP <input checked="" type="checkbox"/> PVC <input type="checkbox"/> Weight 1.8 lbs./ft. Dia. 5 in. to 72 ft. depth Wall Thickness: inches or Dia. <input type="checkbox"/> in. to <input type="checkbox"/> ft. depth Gauge No. .250		
sand coarse		25	44	10. Screen: Manufacturer's name Jess & Lowell Type RMP Dia. 5" Slot/gauze 1/16" Length 20' Set between 72 ft. and 92 ft. ft. and 1 1/8" Gravel pack? yes Size range of material 1/4 X 1/8"		
rock H		44	51	11. Static water level: 30 ft. below land surface Date 7-25-1978		
clay		51	59	12. Pumping level below land surfaces: NA ft. after hrs. pumping g.p.m. ft. after hrs. pumping g.p.m. Estimated maximum yield g.p.m.		
rock		59	61	13. Water sample submitted: Yes <input checked="" type="checkbox"/> No <input type="checkbox"/> Date		
sand coarse		61	65	14. Well head completion: <input type="checkbox"/> Pitless adapter 12 inches above grade		
clay		65	70	15. Well grouted? yes With: <input checked="" type="checkbox"/> Neat cement <input type="checkbox"/> Bentonite <input type="checkbox"/> Concrete Depth: From 0 ft. to 15 ft.		
fine sand clay		70	81	16. Nearest source of possible contamination: ft. 100 Direction north Type Farmstead Well disinfected upon completion? <input checked="" type="checkbox"/> Yes <input type="checkbox"/> No		
sand coarse		81	87	17. Pump: <input checked="" type="checkbox"/> Not installed Manufacturer's name Model number HP Volts Length of drop pipe ft. capacity g.p.m. Type: <input type="checkbox"/> Submersible <input type="checkbox"/> Turbine <input type="checkbox"/> Jet <input type="checkbox"/> Reciprocating <input type="checkbox"/> Centrifugal <input type="checkbox"/> Other		
yellow		87	95	20. Water well contractor's certification: This well was drilled under my jurisdiction and this report is true to the best of my knowledge and belief. Weishaar Drilling & Supp. 232 Business name License No. Address Signature [Signature] Date 8/22/78 Authorized representative		
18. Elevation:		19. Remarks:				
Topography: <input type="checkbox"/> Hill <input checked="" type="checkbox"/> Slope <input type="checkbox"/> Upland <input type="checkbox"/> Valley						

Forward the white, blue and pink copies to the Department of Health and Environment

Form WW-5