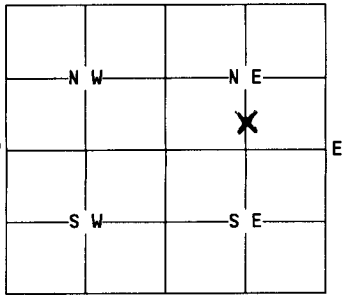


1	LOCATION OF WATER WELL: County: <u>Lane</u>	Fraction <u>NE</u> 1/4 1/4 1/4	Section Number <u>6</u>	Township Number <u>17</u>	Range Number <u>29 W</u>
---	--	--------------------------------------	----------------------------	------------------------------	-----------------------------

Distance and direction from nearest town or city street address of well if located within city?  
3 miles east of Healy

2 WATER WELL OWNER: Janice Shay  
RR#, St. Address, Box #: Box 196 Board of Agriculture, Division of Water Resources  
City, State, ZIP Code: Healy, KS 67850 Application Number: None

3	MARK WELL'S LOCATION WITH AN "X" IN SECTION BOX: N  S	4	DEPTH OF WELL..... <u>115</u> .....ft. WELL'S STATIC WATER LEVEL... <u>106</u> .....ft. WELL WAS USED AS: 1 Domestic 2 Irrigation 3 Feedlot 4 Industrial 5 Public Water Supply 6 <input checked="" type="checkbox"/> Oil Field Water Supply 7 Lawn and Garden Only 8 Air Conditioning 9 Dewatering 10 Monitoring Well 11 Injection Well 12 Other..... Was a chemical/bacteriological sample submitted to Department? Yes.....No... <input checked="" type="checkbox"/> If yes, mo/day/yr sample was submitted..... Water Well Disinfected: Yes... <input checked="" type="checkbox"/> No.....
---	---	---	--

5 TYPE OF BLANK CASING USED:  
1 Steel 3 RMP (SR) 5 Wrought 7 Fiberglass 9 Other (specify below)  
 PVC 4 ABS 6 Asbestos-Cement 8 Concrete Tile  
Blank casing diameter...6...in. Was casing pulled? Yes..... No... If yes, how much.....  
Casing height above or below land surface...3 ft. below...in.

6 GROUT PLUG MATERIAL: 1 Neat cement 2 Cement grout  Bentonite 4 Other.....  
Grout Plug Intervals: From 13.ft. to Surface.ft., From.....ft. to .....ft., From..... to .....ft.  
What is the nearest source of possible contamination:  
1 Septic tank 6 Seepage pit 11 Fuel storage 16 Other (specify below)  
2 Sewer lines 7 Pit privy 12 Fertilizer storage  
3 Watertight sewer lines 8 Sewage lagoon 13 Insecticide storage  
4 Lateral lines 9 Feedyard 14 Abandoned water well  
5 Cess Pool 10 Livestock pens  Oil well/Gas well  
Direction from well? South West How many feet? 50 ft.

FROM	TO	PLUGGING MATERIALS
<u>115</u>	<u>100</u>	<u>Cleaned Sand</u>
<u>100</u>	<u>13</u>	<u>Clean Subsoil</u>
<u>13</u>	<u>3 below surface</u>	<u>Bentonite Clay</u>

7 CONTRACTOR'S OR LANDOWNER'S CERTIFICATION: This water well was plugged under my jurisdiction and was completed on (mo/day/year)..... and this record is true to the best of my knowledge and belief. Kansas Water Well Contractor's License No. .... This Water Well Record was completed on (mo/day/year)..... under the business name of .....  
by (signature) Janice Shay

INSTRUCTIONS: Use typewriter or ball point pen. Please press firmly and print clearly. Please fill in blanks, underline or circle the correct answers. Send top three copies to Kansas Department of Health and Environment, Bureau of Water, Topeka, Kansas 66620-0001. Telephone: 913/296-3565. Send one to Water Well Owner and retain one for your records.