WATER WELL RECORD Form WWC-5 KSA 82a-1212 ID No. _____

| 1 LOCATION OF WATER WELL: | Fraction | Section Number | Township Number | Range Number |
|---|---|---|---|---|
| County: McPherson | SW ¼ SW ¼ SE ¼ | 17 | T 17 S | R 3 X W |

Distance and direction from nearest town or city street address of well if located within city?

In city limits - 513 S. Main, Lindsborg, KS

2 WATER WELL OWNER: May Fitchett

RR#, St. Address, Box # : 513 So. Main

City, State, ZIP Code : Lindsborg, KS 67456

Board of Agriculture, Division of Water Resources Application Number:

3 LOCATE WELL'S LOCATION WITH AN "X" IN SECTION BOX:

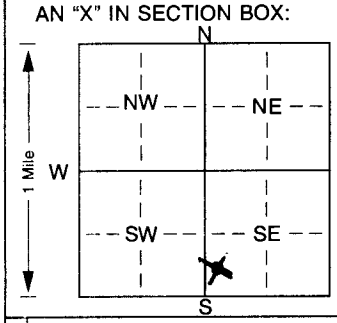


4 DEPTH OF COMPLETED WELL....77..... ft. ELEVATION:.....

Depth(s) Groundwater Encountered 1.....ft. 2.....ft. 3.....ft.

WELL'S STATIC WATER LEVEL....20...ft. below land surface measured on mo/day/yr .....7/24/01.....

Pump test data: Well water was .....ft. after ..... hours pumping ..... gpm

Est. Yield .....gpm: Well water was .....ft. after ..... hours pumping ..... gpm

Bore Hole Diameter....9.....in. to ....77.....ft., and.....in. to .....ft.

WELL WATER TO BE USED AS: 5 Public water supply 8 Air conditioning 11 Injection well
1 Domestic 3 Feedlot 6 Oil field water supply 9 Dewatering 12 Other (Specify below)
2 Irrigation 4 Industrial X Domestic (lawn & garden) 10 Monitoring well .....

Was a chemical/bacteriological sample submitted to Department? Yes..... No...X.; If yes, mo/day/yrs sample was submitted

Water Well Disinfected? Yes X No

5 TYPE OF BLANK CASING USED: 5 Wrought iron 8 Concrete tile CASING JOINTS: Glued X ... Clamped.....
1 Steel 3 RMP (SR) 6 Asbestos-Cement 9 Other (specify below) Welded.....
2 X PVC 4 ABS 7 Fiberglass ..... Threaded.....

Blank casing diameter....5.....in. to ....67.....ft., Dia .....in. to .....ft., Dia .....in. to .....ft.

Casing height above land surface....12.....in., weight .....2.37..... lbs./ft. Wall thickness or gauge No.....214.....

TYPE OF SCREEN OR PERFORATION MATERIAL: X PVC 10 Asbestos-cement
1 Steel 3 Stainless steel 5 Fiberglass 8 RMP (SR) 11 Other (specify).....
2 Brass 4 Galvanized steel 6 Concrete tile 9 ABS 12 None used (open hole)

SCREEN OR PERFORATION OPENINGS ARE: 5 Gauzed wrapped 8 Saw cut 11 None (open hole)
1 Continuous slot 3 X Mill slot 6 Wire wrapped 9 Drilled holes
2 Louvered shutter 4 Key punched 7 Torch cut 10 Other (specify).....ft.

SCREEN-PERFORATED INTERVALS: From.....67..... ft. to .....77..... ft., From ..... ft. to..... ft.
From..... ft. to ..... ft., From ..... ft. to..... ft.
GRAVEL PACK INTERVALS: From.....22..... ft. to .....77..... ft., From ..... ft. to..... ft.
From..... ft. to ..... ft., From ..... ft. to..... ft.

6 GROUT MATERIAL: 1 Neat cement 2 Cement grout X Bentonite 4 Other .....

Grout Intervals: From.....0.....ft. to .....22.....ft., From .....ft. to.....ft., From .....ft. to.....ft.

What is the nearest source of possible contamination: 10 Livestock pens 14 Abandoned water well
1 Septic tank 4 Lateral lines 7 Pit privy 11 Fuel storage 15 Oil well/Gas well
2 Sewer lines 5 Cess pool 8 Sewage lagoon 12 Fertilizer storage 16 Other (specify below)
X 3 Watertight sewer lines 6 Seepage pit 9 Feedyard 13 Insecticide storage .....

Direction from well? West How many feet? 100

| FROM | TO | LITHOLOGIC LOG | FROM | TO | PLUGGING INTERVALS |
|---|---|---|---|---|---|
| 0 | 2 | Topsoil | | | |
| 2 | 38 | Clay, tan | | | |
| 38 | 52 | Clay, gray | | | |
| 52 | 60 | Sand, Coarse | | | |
| 60 | 69 | Sand, fine | | | |
| 69 | 77 | Sand, fine to medium | | | |

7 CONTRACTOR'S OR LANDOWNER'S CERTIFICATION: This water well was (1) X constructed, (2) reconstructed, or (3) plugged under my jurisdiction and was completed on (mo/day/year) .....7/27/01..... and this record is true to the best of my knowledge and belief. Kansas Water Well Contractor's Licence No....138..... This Water Well Record was completed on (mo/day/yr) .....8/2/01.....

under the business name of Peterson Irrigation, Inc. by (signature) Mike Peterson

INSTRUCTIONS: Use typewriter or ball point pen. *PLEASE PRESS FIRMLY* and *PRINT* clearly. Please fill in blanks, underline or circle the correct answers. Send top three copies to Kansas Department of Health and Environment, Bureau of Water, Topeka, Kansas 66620-0001. Telephone 785-296-5524. Send one to WATER WELL OWNER and retain one for your records. Fee of $5.00 for each constructed well.