

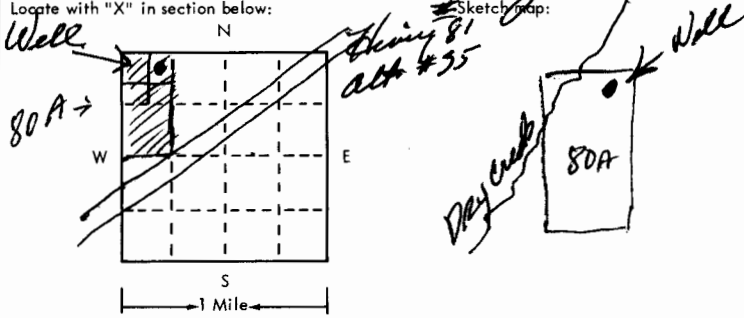
USE TYPEWRITER OR BALL
POINT PEN-PRESS FIRMLY,
PRINT CLEARLY.

WATER WELL RECORD
KSA 82a-1201-1215

T R EW sec 1/4 1/4 1/4 No.

Kansas State Dept. Of Health
(Water Well Contractors)
Forbes-Bldg. 740
Topeka, Kansas 66620

W 1/2 - NW 1/4

1 Location of well:	County McPherson	Township name SMOKEY HILL	Fraction NW 1/4	Section number 3	Town number T17-S	Range number R-3-W
Distance and direction from nearest town or city: 1 1/2 N - 1 1/4 East			3 Owner of well: GORDON BENSTON			
Street address of well location if in city: Lindsborg, Kans.			Address: RFD I LINDSBORG, KANSAS			
Locate with "X" in section below: 			4 Well depth: 61 ft. Date of completion 3-1-75 Well diameter 32 in.			
2 Type and color of material			5 <input type="checkbox"/> Cable tool <input type="checkbox"/> Rotary <input type="checkbox"/> Driven <input type="checkbox"/> Dug <input type="checkbox"/> Hollow rod <input type="checkbox"/> Jetted <input type="checkbox"/> Bored <input checked="" type="checkbox"/> Reverse rotary			
			6 Use: <input type="checkbox"/> Domestic <input type="checkbox"/> Public supply <input type="checkbox"/> Industry <input checked="" type="checkbox"/> Irrigation <input type="checkbox"/> Air conditioning <input type="checkbox"/> Commercial <input type="checkbox"/> Test well			
From To			7 Casing: Material TRANSITE Height: above 18 in. Threading <input type="checkbox"/> Welded <input type="checkbox"/> Surface 18 in. Diam. 32 in. to 61 ft. depth Drive shoe? <input type="checkbox"/> Yes <input type="checkbox"/> No 16 in. to 61 ft. depth			
			8 Screen: Manufacturer JOHN'S MAN'SFIELD Type TRANSITE Dia. 16" I.D. Slope 18 Length 26 FT. Set between 35 ft. and 61 ft. Fittings: Gravel pack <input checked="" type="checkbox"/> Yes <input checked="" type="checkbox"/> No Size range of material 1/4 in.			
Black top soil			0	3	9 Static water level: 16 ft. below land surface Date 3-3-75	
Grey clay - Hard			3	16	10 Pumping level below land surfaces: 46 ft. after 1 hrs. pumping 670 g.p.m. 53 ft. after 2 1/2 hrs. pumping 710 g.p.m. Estimated maximum yield 700 g.p.m.	
Grey clay - Soft			16	35	11 Water sample submitted: <input type="checkbox"/> Yes <input checked="" type="checkbox"/> No Date	
Gravel - Coarse			35	46	12 Well head completion: <input checked="" type="checkbox"/> Pitless adapter 12 inches above grade	
Dark Grey clay			46	49	13 Well grouted? <input checked="" type="checkbox"/> Yes <input type="checkbox"/> No <input type="checkbox"/> Neat cement <input type="checkbox"/> Bentonite <input checked="" type="checkbox"/> Puddled Depth: From 0 ft. to 12 ft. CLAY	
Gravel - Coarse			49	60	14 Nearest source of possible contamination: House ft. 1000 Direction West Type Well Well disinfected upon completion? <input type="checkbox"/> Yes <input checked="" type="checkbox"/> No	
Shale - Green			60	61	15 Pump: <input type="checkbox"/> Not installed Manufacturer's name WESTERN LAND PUMP Model number 6M HP 20 Volts 480 Length of drop pipe 58 ft. capacity 200 g.p.m. Type: <input type="checkbox"/> Submersible <input checked="" type="checkbox"/> Turbine <input type="checkbox"/> Jet <input type="checkbox"/> Reciprocating <input type="checkbox"/> Centrifugal <input type="checkbox"/> Other	
(use a second sheet if needed)					17 Water well contractor's certification: This well was drilled under my jurisdiction and this report is true to the best of my knowledge and belief. PETER BROSZ INC. 138 Business name License No. Address Box 150 Lindsborg, KS Signed Warren N. Peterson Date 3-5-75 Authorized representative	
16 Remarks: elevation Topography: <input type="checkbox"/> Hill <input type="checkbox"/> Slope <input type="checkbox"/> Upland <input checked="" type="checkbox"/> Valley Well is on flat ground.						