USE TYPEWRITER OR BALL POINT PEN-PRESS FIRMLY, PRINT CLEARLY.

WATER WELL RECORD
KSA 82a-1201-1215

Kansas Department of Health and Environment-Division of Environment
(Water well Contractors)
Topeka, Kansas 66620

1. Location of well:	County	Fraction	Section number	Township number	Range number
	McPherson	NW 1/4 SE 1/4 SE 1/4	8	T 17 S	R 3 W

2. Distance and direction from nearest town or city: ½ mi. N of
Street address of well location if in city: Lindsborg Ks.

3. Owner of well: Willard Keding
R.R. or street: 208 S 1st
City, state, zip code: Lindsborg, Ks. 67456

4. Locate with "X" in section below: Sketch map:

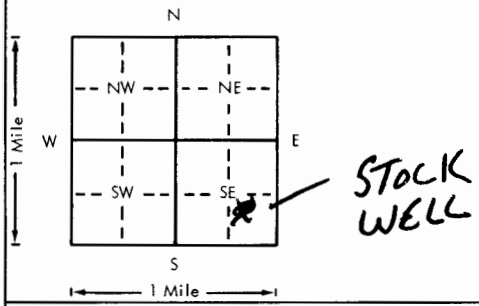

6. Bore hole dia. 8 in. Completion date 7-2-79
Well depth 80 ft.

7. __ Cable tool X Rotary __ Driven __ Dug
__ Hollow rod __ Jetted __ Bored __ Reverse rotary

8. Use: __ Domestic __ Public supply __ Industry
__ Irrigation __ Air conditioning X Stock
__ Lawn __ Oil field water __ Other

9. Casing: Material _____ Height Above or below Surface 24 in.
Threaded ____ Welded ____
RMP ____ PVC X Weight 2 lbs./ft.
Dia. 4 in. to 70 ft. depth Wall Thickness: inches or gage No. .25 in
Dia. ____ in. to ____ ft. depth

10. Screen: Manufacturer's name Peerless Plastics
Type PVC Dia. 4"
Slot/gauze 1/32 Length 10 ft
Set between 70 ft. and 80 ft.
____ ft. and ____ ft.
Gravel pack? Yes Size range of material ¼ in

11. Static water level: 23 ft. below land surface Date 7-2-79 mo./day/yr.

12. Pumping level below land surfaces: 25 ft. after 1½ hrs. pumping 12 g.p.m.
____ ft. after ____ hrs. pumping ____ g.p.m.
Estimated maximum yield 30 g.p.m.

13. Water sample submitted: mo./day/yr.
__ Yes X No Date

14. Well head completion:
__ Pitless adapter 20 Inches above grade

15. Well grouted? Yes
With: X Neat cement ____ Bentonite ____ Concrete
Depth: From 0 ft. to 10 ft.

16. Nearest source of possible contamination: Horses
ft. 100 Direction NE Type
Well disinfected upon completion? X Yes ____ No

17. Pump: X Not installed
Manufacturer's name
Model number ____ HP ____ Volts ____
Length of drop pipe ____ ft. capacity ____ g.p.m.
Type:
__ Submersible __ Turbine
__ Jet __ Reciprocating
__ Centrifugal __ Other

5. Type and color of material

	From	To
Top Soil	0	2
Gray Clay	2	32
Fine Sand	32	37
Med Sand	37	53
Medium Course Sand	53	80

(Use a second sheet if needed)

18. Elevation:
Topography:
__ Hill
__ Slope
__ Upland
X Valley

19. Remarks:

20. Water well contractor's certification:
This well was drilled under my jurisdiction and this report is true to the best of my knowledge and belief.
Business name Peterson Irrigation License No. 138
Address Box 150 Lindsborg Ks
Signed Mike Peterson Date 7-14-79
Authorized representative

T 17 — R 3 E/W — Sec 8 — 1/4 NW 1/4 SE 1/4 SE 1/4

Forward the white, blue and pink copies to the Department of Health and Environment

Form WWC-5

MI-1023