USE TYPEWRITER OR BALL POINT PEN-PRESS FIRMLY, PRINT CLEARLY.

17	3	W	8	SW	SE	SE
T	R	EW	sec 1/4 1/4 1/4 No.			

WATER WELL RECORD
KSA 82a-1201-1215

Kansas State Dept. Of Health
(Water Well Contractors)
Forbes-Bldg. 740
Topeka, Kansas 66620

1 Location of well:	County	Township name	Fraction	Section number	Town number	Range number
	McPherson	Smoky Hill	12, 1 acre in S.E¼-SE¼	8	T-17-S	R-3-W

Distance and direction from nearest town or city: Bethany College

Street address of well location if in city: N. Kansas Ave.

3 Owner of well: Bethany College

Address: Lindsborg, Kans.

Locate with "X" in section below:

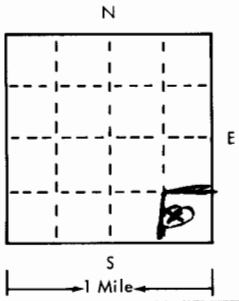

Sketch map:

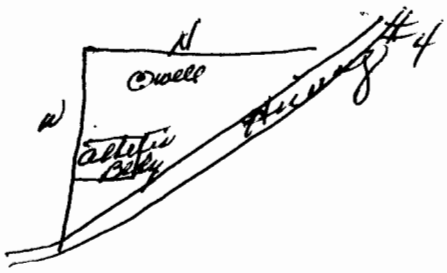

4 Well depth: 77 ft. Date of completion 9-15-75
Well diameter 12" in.

5 ☐ Cable tool ☒ Rotary ☐ Driven ☐ Dug ☐ Hollow rod ☐ Jetted ☐ Bored ☐ Reverse rotary

6 Use: ☐ Domestic ☐ Public supply ☐ Industry ☒ Irrigation ☐ Air conditioning ☐ Commercial ☐ Test well ☐

7 Casing: Material PVC Height: above/below
Threaded ☐ Welded ☒ Surface 12 in.
Diam. Weight ___ lbs./ft.
10 in. to 77 ft. depth Drive shoe? ☐ Yes ☒ No
___ in. to ___ ft. depth

2

Type and color of material	From	To
Top soil	0	2
Silty Clays	2	33
Blue Clays	33	46
Drift wood	46	48
Medsands & Coarse gravels	48	59
Blue clays	59	65
Fine to med sands & gravels	65	76
Blue shale	76	83

(use a second sheet if needed)

8 Screen:
Manufacturer Certain Teed
Type PVC Dia. 10"
Slot/gauze 42 Length 20'
Set between 57 ft. and 77 ft.
Fittings: 48 - 44"
Gravel pack ☒ Yes ☐ No Size range of material ___

9 Static water level:
20 ft. below land surface Date 9-15-75

10 Pumping level below land surfaces:
60 ft. after 5 hrs. pumping 450 g.p.m.
___ ft. after ___ hrs. pumping ___ g.p.m.
Estimated maximum yield 500 g.p.m.

11 Water sample submitted:
☐ Yes ☒ No Date ___

12 Well head completion: 12"
☐ Pitless adapter ☒ Inches above grade

13 Well grouted? ☒ Yes ☐ No
☒ Neat cement ☐ Bentonite ☐ ___
Depth: From 0 ft. to 15 ft.

14 Nearest source of possible contamination: City Sewer Line
ft. 450 Direction South Type
Well disinfected upon completion? ☒ Yes ☐ No

15 Pump: ☐ Not installed
Manufacturer's name Western Land Roller
Model number 4M HP 15 Volts 230
Length of drop pipe 20 ft. capacity 450 g.m.p.
Type:
☐ Submersible ☒ Turbine
☐ Jet ☐ Reciprocating
☐ Certrifugal ☐ Other

16 Remarks: elevation

Topography: Flat land.
☐ Hill
☐ Slope
☐ Upland
☒ Valley

17 Water well contractor's certification:
This well was drilled under my jurisdiction and this report is true to the best of my knowledge and belief.
Peterson Bros Inc. 138
Business name License No.
Address Box 150 Lindsborg Ks
Signed Wally Peterson Jr. Date 9-15-75
Authorized representative

17 3W 8 SWSESE

Forward the white, blue and pink copies to the Kansas State Dept. Of Health.

Form WWC-5

677-H