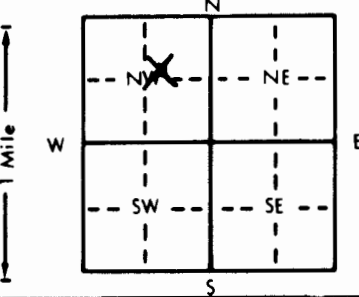


1 LOCATION OF WATER WELL: Fraction NE Section Number 17 Township Number T 17 S Range Number R 3
 County: McPherson Near 1/4 Center 1/4 NW 1/4

Distance and direction from nearest town or city street address of well if located within city?
429 Washington, In city limits

2 WATER WELL OWNER: Jim Toews
 RR#, St. Address, Box # : 429 N. Washington Board of Agriculture, Division of Water Resources
 City, State, ZIP Code : Lindsborg, KS 67456 Application Number:

3 LOCATE WELL'S LOCATION WITH AN "X" IN SECTION BOX:


4 DEPTH OF COMPLETED WELL... 58 1/2 ft. ELEVATION:
 Depth(s) Groundwater Encountered 1. 32 ft. 2. 32 ft. 3. 32 ft.
 WELL'S STATIC WATER LEVEL 32 ft. below land surface measured on mo/day/yr 4-5-91
 Pump test data: Well water was 35 ft. after 1 hours pumping 12 gpm
 Est. Yield 50 gpm: Well water was 35 ft. after 1 hours pumping 12 gpm
 Bore Hole Diameter 8 in. to 60 ft. and 60 in. to 60 ft.
 WELL WATER TO BE USED AS: 5 Public water supply 8 Air conditioning 11 Injection well
 1 Domestic 3 Feedlot 6 Oil field water supply 9 Dewatering 12 Other (Specify below)
 2 Irrigation 4 Industrial 7 Lawn and garden only 10 Monitoring well
 Was a chemical/bacteriological sample submitted to Department? Yes.....No X..... If yes, mo/day/yr sample was submitted
 Water Well Disinfected? Yes X No

5 TYPE OF BLANK CASING USED:
 1 Steel 3 RMP (SR) 6 Asbestos-Cement 9 Other (specify below) Welded
 2 PVC 4 ABS 7 Fiberglass Threaded
 Blank casing diameter 5 in. to 48 1/2 ft. Dia 5 in. to 48 1/2 ft. Dia 5 in. to 48 1/2 ft. Dia
 Casing height above land surface 12 in., weight 2.37 lbs./ft. Wall thickness or gauge No. .214
 TYPE OF SCREEN OR PERFORATION MATERIAL:
 1 Steel 3 Stainless steel 5 Fiberglass 8 RMP (SR) 10 Asbestos-cement
 2 Brass 4 Galvanized steel 6 Concrete tile 9 ABS 11 Other (specify)
 12 None used (open hole)
 SCREEN OR PERFORATION OPENINGS ARE:
 1 Continuous slot 3 Mill slot 5 Gauzed wrapped 8 Saw cut 11 None (open hole)
 2 Louvered shutter 4 Key punched 6 Wire wrapped 9 Drilled holes
 7 Torch cut 10 Other (specify)
 SCREEN-PERFORATED INTERVALS: From 48 1/2 ft. to 58 1/2 ft., From 48 1/2 ft. to 58 1/2 ft., From 48 1/2 ft. to 58 1/2 ft.
 GRAVEL PACK INTERVALS: From 25 ft. to 58 1/2 ft., From 25 ft. to 58 1/2 ft., From 25 ft. to 58 1/2 ft.

6 GROUT MATERIAL: 1 Neat cement 2 Cement grout 3 Bentonite 4 Other
 Grout intervals: From 5 ft. to 25 ft., From 5 ft. to 25 ft., From 5 ft. to 25 ft., From 5 ft. to 25 ft.
 What is the nearest source of possible contamination:
 1 Septic tank 4 Lateral lines 7 Pit privy 10 Livestock pens 14 Abandoned water well
 2 Sewer lines 5 Cess pool 8 Sewage lagoon 11 Fuel storage 15 Oil well/Gas well
 3 Watertight sewer lines 6 Seepage pit 9 Feedyard 12 Fertilizer storage 16 Other (specify below)
 13 Insecticide storage

Direction from well? West How many feet? 50 ft.

FROM	TO	LITHOLOGIC LOG	FROM	TO	PLUGGING INTERVALS
0	3	Top Soil			
3	25	Brown Clay			
25	30	Gray Clay (hard)			
30	42	Gray Clay			
42	45	Fine Sand			
45	60	Medium Tan Sand			

7 CONTRACTOR'S OR LANDOWNER'S CERTIFICATION: This water well was (1) constructed, (2) reconstructed, or (3) plugged under my jurisdiction and was completed on (mo/day/year) 4-5-91 and this record is true to the best of my knowledge and belief. Kansas Water Well Contractor's License No. 138 This Water Well Record was completed on (mo/day/year) 4-18-91 under the business name of Peterson Irrigation, Inc. by (signature) Mike Peterson

OFFICE USE ONLY
T
R
EM
SEC.
1/4
1/4
1/4