


1 LOCATION OF WATER WELL: Fraction NW 1/4 NW 1/4 SE 1/4 Section Number 17 Township Number T 17 S Range Number R 3

Distance and direction from nearest town or city street address of well if located within city? In City Limits-201 S. 2nd, Lindsborg, KS

2 WATER WELL OWNER: Douglas Olson RR#, St. Address, Box #: 201 S. 2nd City, State, ZIP Code: Lindsborg, KS 67456 Board of Agriculture, Division of Water Resources Application Number:

3 LOCATE WELL'S LOCATION WITH AN 'X' IN SECTION BOX: 4 DEPTH OF COMPLETED WELL: 55 ft. ELEVATION: ...

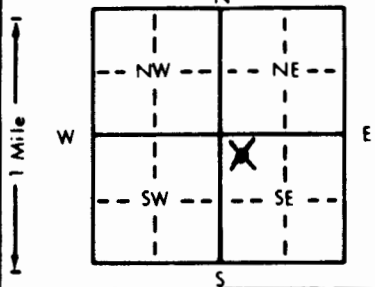

Depth(s) Groundwater Encountered 1. 30 ft. 2. ... ft. 3. ... ft. WELL'S STATIC WATER LEVEL 30 ft. below land surface measured on mo/day/yr 9-16-91 Pump test data: Well water was ... ft. after ... hours pumping ... gpm Est. Yield 1.5-20 gpm: Well water was 31 ft. after 1 hours pumping 10 gpm Bore Hole Diameter .8 in. to 5.5 ft. and ... in. to ... ft. WELL WATER TO BE USED AS: 5 Public water supply 8 Air conditioning 11 Injection well 1 Domestic 3 Feedlot 6 Oil field water supply 9 Dewatering 12 Other (Specify below) 2 Irrigation 4 Industrial 7 Lawn and garden only 10 Monitoring well ... Was a chemical/bacteriological sample submitted to Department? Yes ... No [X] ... If yes, mo/day/yr sample was submitted Water Well Disinfected? Yes [X] No

5 TYPE OF BLANK CASING USED: 1 Steel 2 PVC 3 RMP (SR) 4 ABS 5 Wrought iron 6 Asbestos-Cement 7 Fiberglass 8 Concrete tile 9 Other (specify below) CASING JOINTS: Glued [X] Clamped Welded Threaded

Blank casing diameter 5 in. to 4.5 ft. Dia. in. to ... ft. Dia. in. to ... ft. Casing height above land surface 1.2 in., weight 2.37 lbs./ft. Wall thickness or gauge No. 21.4

TYPE OF SCREEN OR PERFORATION MATERIAL: 1 Steel 2 Brass 3 Stainless steel 4 Galvanized steel 5 Fiberglass 6 Concrete tile 7 PVC 8 RMP (SR) 9 ABS 10 Asbestos-cement 11 Other (specify) 12 None used (open hole)

SCREEN OR PERFORATION OPENINGS ARE: 1 Continuous slot 2 Louvered shutter 3 Mill slot 4 Key punched 5 Gauzed wrapped 6 Wire wrapped 7 Torch cut 8 Saw cut 9 Drilled holes 10 Other (specify) 11 None (open hole)

SCREEN-PERFORATED INTERVALS: From 45 ft. to 55 ft. From ... ft. to ... ft. GRAVEL PACK INTERVALS: From 25 ft. to 55 ft. From ... ft. to ... ft.

6 GROUT MATERIAL: 1 Neat cement 2 Cement grout 3 Bentonite 4 Other Grout intervals: From 5 ft. to 25 ft. From ... ft. to ... ft.

What is the nearest source of possible contamination: 1 Septic tank 2 Sewer lines 3 Watertight sewer lines 4 Lateral lines 5 Cess pool 6 Seepage pit 7 Pit privy 8 Sewage lagoon 9 Feedyard 10 Livestock pens 11 Fuel storage 12 Fertilizer storage 13 Insecticide storage 14 Abandoned water well 15 Oil well/Gas well 16 Other (specify below)

Direction from well? West How many feet? 80 ft

Table with columns: FROM, TO, LITHOLOGIC LOG, FROM, TO, PLUGGING INTERVALS. Rows: 0-3 Top Soil, 3-19 Gray Clay, 19-32 Silty Gray Clay, 32-55 Fine to Medium Sands

7 CONTRACTOR'S OR LANDOWNER'S CERTIFICATION: This water well was (1) constructed, (2) reconstructed, or (3) plugged under my jurisdiction and was completed on (mo/day/year) 9-16-91 and this record is true to the best of my knowledge and belief. Kansas Water Well Contractor's License No. 138 This Water Well Record was completed on (mo/day/yr) 9-12-91 under the business name of Peterson Irrigation, Inc. by (signature) Mike Peterson

INSTRUCTIONS: Use typewriter or ball point pen. PLEASE PRESS FIRMLY and PRINT clearly. Please fill in blanks, underline or circle the correct answers. Send top three copies to Kansas Department of Health and Environment, Bureau of Water, Topeka, Kansas 66620-0001. Telephone: 913-296-5545. Send one to WATER WELL OWNER and retain one for your records.

OFFICE USE ONLY T R EW SEC. 1/4 1/4 1/4