USE TYPEWRITER OR BALL POINT PEN-PRESS FIRMLY, PRINT CLEARLY.

WATER WELL RECORD
KSA 82a-1201-1215

Kansas Department of Health and Environment-Division of Environment
(Water well Contractors)
Topeka, Kansas 66620

1. Location of well:	County	Fraction	Section number	Township number	Range number
	McPherson	SE 1/4 SE 1/4 SE 1/4	19	T 17 S	R 3 W

2. Distance and direction from nearest town or city: 1mi S
Street address of well location if in city: 1mi W of LINDSBORG

3. Owner of well: Glen Nelson
R.R. or street: RR
City, state, zip code: Lindsborg, Kansas 67456

4. Locate with "X" in section below: Sketch map:

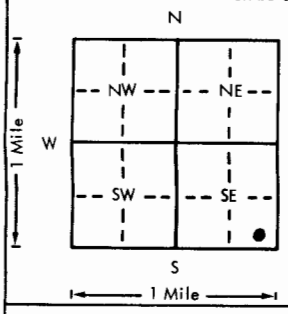

DOMESTIC WELL

6. Bore hole dia. 8 in. Completion date 8-28-78
Well depth 60 ft.

7. __ Cable tool X Rotary __ Driven __ Dug
__ Hollow rod __ Jetted __ Bored __ Reverse rotary

8. Use: X Domestic __ Public supply __ Industry
__ Irrigation __ Air conditioning __ Stock
__ Lawn __ Oil field water __ Other

9. Casing: Material _____ Height: Above or below
Threaded ____ Welded ____ Surface 12 in.
RMP ____ PVC X Weight 2 lbs./ft.
Dia. 4 in. to 52 ft. depth Wall Thickness: inches or
Dia. ____ in. to ____ ft. depth gage No. .25 in.

5. Type and color of material	From	To
Top soil	0	5
Buff clay	5	25
Fine sand	25	40
Gray clay	40	45
Med. course sand + gravel	45	62
(Use a second sheet if needed)		

10. Screen: Manufacturer's name Peerless Plastics
Type P.V.C. Dia. 4"
Slot/gauze 116 Length 10'
Set between 52 ft. and 62 ft.
____ ft. and ____ ft.
Gravel pack? Yes Size range of material 1/4 in

11. Static water level: mo./day/yr.
25 ft. below land surface Date 8-28-78

12. Pumping level below land surfaces:
28 ft. after 1 hrs. pumping 10-15 g.p.m.
____ ft. after ____ hrs. pumping ____ g.p.m.
Estimated maximum yield 20 g.p.m.

13. Water sample submitted: mo./day/yr.
__ Yes X No Date ____

14. Well head completion:
__ Pitless adapter 12 Inches above grade

15. Well grouted? Yes
With: X Neat cement ____ Bentonite ____ Concrete
Depth: From 5 ft. to 15 ft.

16. Nearest source of possible contamination:
ft. 2000 Direction SE Type Cattle
Well disinfected upon completion? X Yes ____ No

17. Pump: X Not installed
Manufacturer's name ____
Model number ____ HP ____ Volts ____
Length of drop pipe ____ ft. capacity ____ g.p.m.
Type:
__ Submersible __ Turbine
__ Jet __ Reciprocating
__ Centrifugal __ Other

T 17 R 3 E W Sec 19 1/4 SE 1/4 SE 1/4 SE 1/4

18. Elevation:
Topography:
__ Hill
__ Slope
__ Upland
X Valley

19. Remarks:

20. Water well contractor's certification:
This well was drilled under my jurisdiction and this report is true to the best of my knowledge and belief.
Business name PETERSON IRRIGATION License No. 138
Address Box 150 LINDSBORG, KS
Signed Mike Peterson Date 9-25-78
Authorized representative

Forward the white, blue and pink copies to the Department of Health and Environment

Form WWC-5

M1-1023