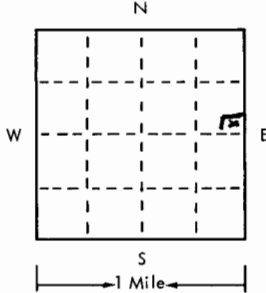
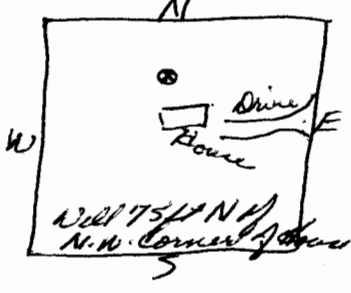


USE TYPEWRITER OR BALL POINT PEN-PRESS FIRMLY, PRINT CLEARLY.

17 3W 27 SE SE NE
T R EW sec 1/4 1/4 1/4 No.

WATER WELL RECORD
KSA 82a-1201-1215

Kansas State Dept. Of Health
(Water Well Contractors)
Forbes-Bldg. 740
Topeka, Kansas 66620

1 Location of well:	County <u>McPherson</u>	Township name <u>Smoke Hill</u>	Fraction <u>SE 1/4</u> <u>SE 1/4 Sec 27</u>	Section number <u>27</u>	Town number <u>T-17-5</u>	Range number <u>R-3-W</u>		
Distance and direction from nearest town or city: <u>1 1/2 S - 2 E - 1/4 S</u>			3 Owner of well: <u>Mrs Ellen Paulson</u>					
Street address of well location if in city: <u>Lindenberg Kans</u>			Address: <u>R.R. 2 Lindenberg, Kans.</u>					
Locate with "X" in section below:		Sketch map:		4 Well depth: <u>62</u> ft. Date of completion: <u>10-6-75</u> Well diameter <u>8</u> in.				
				5 <input type="checkbox"/> Cable tool <input checked="" type="checkbox"/> Rotary <input type="checkbox"/> Driven <input type="checkbox"/> Dug <input type="checkbox"/> Hollow rod <input type="checkbox"/> Jetted <input type="checkbox"/> Bored <input type="checkbox"/> Reverse rotary				
2		Type and color of material		From To		6 Use: <input checked="" type="checkbox"/> Domestic <input type="checkbox"/> Public supply <input type="checkbox"/> Industry <input type="checkbox"/> Irrigation <input type="checkbox"/> Air conditioning <input type="checkbox"/> Commercial <input type="checkbox"/> Test well <input type="checkbox"/>		
						7 Casing: Material <u>Pvc</u> (Height: <u>above</u> /below Threaded <input type="checkbox"/> Welded <input checked="" type="checkbox"/> Surface <u>12</u> in. Diam. _____ Weight _____ lbs./ft. _____ <u>2</u> in. to <u>62</u> ft. depth Drive shoe? <input type="checkbox"/> Yes <input checked="" type="checkbox"/> No _____ in. to _____ ft. depth!		
						8 Screen: Manufacturer <u>Centimetal</u> Type <u>PVC</u> Dia. <u>5"</u> Slot/gauze <u>1/32</u> Length <u>10ft.</u> Set between <u>52</u> ft. and <u>62</u> ft. _____ Fittings: <u>1/2 - 1/4"</u> Gravel pack <input checked="" type="checkbox"/> Yes <input type="checkbox"/> No Size range of material _____		
						9 Static water level: <u>32</u> ft. below land surface Date <u>10-6-75</u>		
						10 Pumping level below land surfaces: <u>20</u> ft. after <u>2</u> hrs. pumping <u>6</u> g.p.m. _____ ft. after _____ hrs. pumping _____ g.p.m. Estimated maximum yield <u>6</u> g.p.m.		
						11 Water sample submitted: <input type="checkbox"/> Yes <input checked="" type="checkbox"/> No Date _____		
						12 Well head completion: <u>12"</u> <input checked="" type="checkbox"/> Pitless adapter <input type="checkbox"/> Inches above grade		
						13 Well grouted? <input checked="" type="checkbox"/> Yes <input type="checkbox"/> No <input checked="" type="checkbox"/> Neat cement <input type="checkbox"/> Bentonite <input type="checkbox"/> _____ Depth: From <u>2</u> ft. to <u>15</u> ft.		
						14 Nearest source of possible contamination: ft. <u>20</u> Direction <u>South</u> Type <u>Sewer Pipe</u> Well disinfected upon completion? <input checked="" type="checkbox"/> Yes <input type="checkbox"/> No		
						15 Pump: <input checked="" type="checkbox"/> Not installed Manufacturer's name _____ Model number _____ HP _____ Volts _____ Length of drop pipe _____ ft. capacity _____ g.p.m. Type: <input type="checkbox"/> Submersible <input type="checkbox"/> Turbine <input type="checkbox"/> Jet <input type="checkbox"/> Reciprocating <input type="checkbox"/> Centrifugal <input type="checkbox"/> Other		
16 Remarks: elevation						17 Water well contractor's certification: This well was drilled under my jurisdiction and this report is true to the best of my knowledge and belief. <u>Delivan Bros Inc</u> License No. <u>138</u> Business name _____ Address <u>Box 150 Lindenberg Kans 67456</u> Signed <u>Wally Delivan</u> Date <u>10-6-75</u> <u>By NP</u> Authorized representative		
		Topography: <u>Keen Improvement on Top of Hill</u>						
		<input checked="" type="checkbox"/> Hill						
		<input type="checkbox"/> Slope						
		<input type="checkbox"/> Upland						
		<input type="checkbox"/> Valley						

17 3W 27 SE SE NE