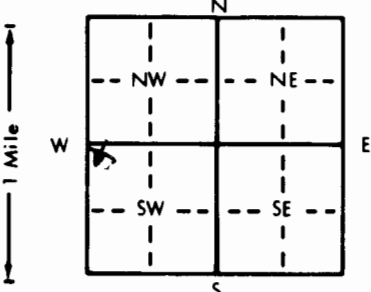


1 LOCATION OF WATER WELL: Fraction NW 1/4 NW 1/4 SW 1/4 Section Number 32 Township Number T 17 S Range Number R 3 E/W
 County: McPherson
 Distance and direction from nearest town or city street address of well if located within city?

2 WATER WELL OWNER: Bob Freeborn Board of Agriculture, Division of Water Resources
 RR#, St. Address, Box # : 300 E. 2nd Application Number:
 City, State, ZIP Code : Assaria, KS 67416

3 LOCATE WELL'S LOCATION WITH AN "X" IN SECTION BOX:  4 DEPTH OF COMPLETED WELL: 59 ft. ELEVATION:
 Depth(s) Groundwater Encountered 1. 37 ft. 2. ft. 3. ft.
 WELL'S STATIC WATER LEVEL .37 ft. below land surface measured on mo/day/yr 1-21-92
 Pump test data: Well water was ft. after hours pumping gpm
 Est. Yield .6-8 gpm: Well water was 45 ft. after 1 hours pumping 6 gpm
 Bore Hole Diameter .8 in. to .62 ft. and in. to ft.
 WELL WATER TO BE USED AS: 5 Public water supply 8 Air conditioning 11 Injection well
 1 Domestic 3 Feedlot 6 Oil field water supply 9 Dewatering 12 Other (Specify below)
 2 Irrigation 4 Industrial 7 Lawn and garden only 10 Monitoring well
 Was a chemical/bacteriological sample submitted to Department? Yes No ; If yes, mo/day/yr sample was submitted
 Water Well Disinfected? Yes No

5 TYPE OF BLANK CASING USED: 5 Wrought iron 8 Concrete tile CASING JOINTS: Glued Clamped
 1 Steel 3 RMP (SR) 6 Asbestos-Cement 9 Other (specify below) Welded
 2 PVC 4 ABS 7 Fiberglass Threaded
 Blank casing diameter .5 in. to .39 ft., Dia in. to ft., Dia in. to ft.
 Casing height above land surface .12 in., weight 2.37 lbs./ft. Wall thickness or gauge No. 214
 TYPE OF SCREEN OR PERFORATION MATERIAL: 7 PVC 10 Asbestos-cement
 1 Steel 3 Stainless steel 5 Fiberglass 8 RMP (SR) 11 Other (specify)
 2 Brass 4 Galvanized steel 6 Concrete tile 9 ABS 12 None used (open hole)
 SCREEN OR PERFORATION OPENINGS ARE: 5 Gauzed wrapped 8 Saw cut 11 None (open hole)
 1 Continuous slot 3 Mill slot 6 Wire wrapped 9 Drilled holes
 2 Louvered shutter 4 Key punched 7 Torch cut 10 Other (specify)
 SCREEN-PERFORATED INTERVALS: From .39 ft. to .59 ft., From ft. to ft.
 From ft. to ft., From ft. to ft.
 GRAVEL PACK INTERVALS: From .25 ft. to .59 ft., From ft. to ft.
 From ft. to ft., From ft. to ft.

6 GROUT MATERIAL: 1 Neat cement 2 Cement grout 3 Bentonite 4 Other
 Grout intervals: From .5 ft. to .25 ft., From ft. to ft., From ft. to ft.
 What is the nearest source of possible contamination:
 1 Septic tank 4 Lateral lines 7 Pit privy 10 Livestock pens 14 Abandoned water well
 2 Sewer lines 5 Cess pool 8 Sewage lagoon 11 Fuel storage 15 Oil well/Gas well
 3 Watertight sewer lines 6 Seepage pit 9 Feedyard 12 Fertilizer storage 16 Other (specify below)
 13 Insecticide storage
 Direction from well? North How many feet? 150

FROM	TO	LITHOLOGIC LOG	FROM	TO	PLUGGING INTERVALS
0	2	Top Soil			
2	8	Green Shale			
8	14	Red Shale			
14	28	Fractured Green Shale			
28	46	Gray Shale			
46	47	Loose Gray Shale			
47	53	Gray Shale			
53	62	Red Shale "hard"			

7 CONTRACTOR'S OR LANDOWNER'S CERTIFICATION: This water well was (1) constructed, (2) reconstructed, or (3) plugged under my jurisdiction and was completed on (mo/day/year) 1-21-92 and this record is true to the best of my knowledge and belief. Kansas Water Well Contractor's License No. 1.38 This Water Well Record was completed on (mo/day/yr) 1-24-92 under the business name of Peterson Irrigation, Inc. by (signature) Mike Peterson