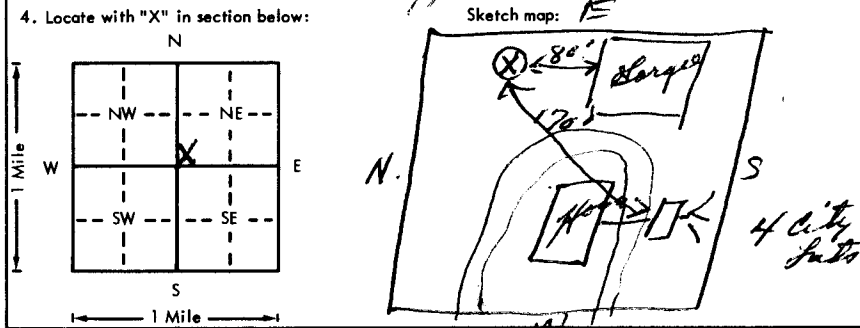


USE TYPEWRITER OR BALL POINT PEN-PRESS FIRMLY, PRINT CLEARLY.

WATER WELL RECORD
KSA 82a-1201-1215

Kansas Department of Health and Environment-Division of Environment
(Water well Contractors)
Topeka, Kansas 66620

1. Location of well: County <u>McPherson</u> Fraction <u>SW 1/4 SW 1/4 NE 1/4</u> Section number <u>17</u> Township number <u>T 17</u> Range number <u>S R 3</u> E/W	
2. Distance and direction from nearest town or city: Street address of well location if in city: <u>251 Jackson</u>	
3. Owner of well: <u>Ray Reising</u> R.R. or street: <u>251 Jackson</u> City, state, zip code: <u>Lindsborg</u>	
4. Locate with "X" in section below: Sketch map: <u>E</u> 	
6. Bore hole dia. <u>8</u> in. Completion date <u>3-6-76</u> Well depth <u>75</u> ft.	
7. <input checked="" type="checkbox"/> Cable tool <input checked="" type="checkbox"/> Rotary <input type="checkbox"/> Driven <input type="checkbox"/> Dug <input type="checkbox"/> Hollow rod <input type="checkbox"/> Jetted <input type="checkbox"/> Bored <input type="checkbox"/> Reverse rotary	
8. Use: <input checked="" type="checkbox"/> Domestic <input type="checkbox"/> Public supply <input type="checkbox"/> Industry <input checked="" type="checkbox"/> Irrigation <input type="checkbox"/> Air conditioning <input type="checkbox"/> Stock <input checked="" type="checkbox"/> Lawn <input type="checkbox"/> Oil field water <input type="checkbox"/> Other	
9. Casing: Material <u>PVC</u> Height: <u>Above</u> or below Threaded <input type="checkbox"/> Welded <input checked="" type="checkbox"/> Surface <u>18"</u> in. RMP <input type="checkbox"/> PVC <input checked="" type="checkbox"/> Weight <input type="checkbox"/> lbs./ft. Dia. <u>5</u> in. to <u>75</u> ft. depth Wall Thickness: inches or Dia. <input type="checkbox"/> in. to <input type="checkbox"/> ft. depth gage No. <u>3/16</u>	
5. Type and color of material	
<u>Top Soil</u>	From <u>0</u> To <u>1</u>
<u>Silty Clay</u>	<u>1</u> <u>42</u>
<u>Very very fine sands & Clay</u>	<u>42</u> <u>58</u>
<u>Med sands & gravel - loose</u>	<u>58</u> <u>75</u>
10. Screen: Manufacturer's name <u>J. Stearns</u> <u>Ralph Yarn Co.</u> Type <u>PVC</u> Dia. <u>5"</u> Slot gauze <u>732</u> Length <u>10'</u> Set between <u>65</u> ft. and <u>75</u> ft. <input type="checkbox"/> ft. and <input type="checkbox"/> ft. Gravel pack? <input checked="" type="checkbox"/> Size range of material <u>16-44</u>	
11. Static water level: <u>246</u> ft. below land surface Date <u>3-8-76</u> mo./day/yr.	
12. Pumping level below land surfaces: <u>26</u> ft. after <u>2</u> hrs. pumping <u>15</u> g.p.m. <input type="checkbox"/> ft. after <input type="checkbox"/> hrs. pumping <input type="checkbox"/> g.p.m. Estimated maximum yield <u>30</u> g.p.m.	
13. Water sample submitted: <input type="checkbox"/> Yes <input checked="" type="checkbox"/> No Date <u>3-8-76</u> mo./day/yr.	
14. Well head completion: <input type="checkbox"/> Pitless adapter <u>18"</u> inches above grade	
15. Well grouted? <input checked="" type="checkbox"/> With: <input checked="" type="checkbox"/> Neat cement <input type="checkbox"/> Bentonite <input type="checkbox"/> Concrete Depth: From <u>0</u> ft. to <u>15</u> ft.	
16. Nearest source of possible contamination: <u>170</u> ft. Direction <u>West</u> Type <u>Septic</u> Well disinfected upon completion? <input checked="" type="checkbox"/> Yes <input type="checkbox"/> No	
17. Pump: <u>used</u> Not installed Manufacturer's name <u>Red Jacket</u> Model number <input type="checkbox"/> HP <u>1</u> Volts <input type="checkbox"/> Length of drop pipe <u>60</u> ft. capacity <input type="checkbox"/> g.p.m. Type: <input checked="" type="checkbox"/> Submersible <input type="checkbox"/> Turbine <input type="checkbox"/> Jet <input type="checkbox"/> Reciprocating <input type="checkbox"/> Centrifugal <input type="checkbox"/> Other	
(Use a second sheet if needed)	
18. Elevation: Topography: <input type="checkbox"/> Hill <input type="checkbox"/> Slope <input type="checkbox"/> Upland <input type="checkbox"/> Valley	19. Remarks: <u>This Reising well from concrete.</u>
20. Water well contractor's certification: This well was drilled under my jurisdiction and this report is true to the best of my knowledge and belief. <u>Robertson Buden</u> <u>138</u> Business name License No. Address <u>1204 15th Lindsborg Kan</u> Signed <u>Wally Adams</u> Date <u>4/20/76</u> Authorized representative	

17-30-17 SW 1/4 NE

Forward the white, blue and pink copies to the Department of Health and Environment

Form WWC-5