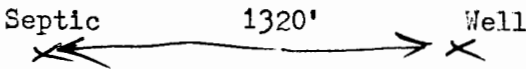


USE TYPEWRITER OR BALL  
POINT PEN-PRESS FIRMLY,  
PRINT CLEARLY.

WATER WELL RECORD  
KSA 82a-1201-1215

Kansas Department of Health and  
Environment-Division of Environment  
(Water well Contractors)  
Topeka, Kansas 66620

1. Location of well:	County <b>Lane</b>	Fraction <b>NW 1/4 SE 1/4 NW 1/4</b>	Section number <b>1</b>	Township number <b>T 17 S</b>	Range number <b>R 30 E</b>
2. Distance and direction from nearest town or city: <b>One east 1/2 north of Healy, Kansas</b> Street address of well location if in city:			3. Owner of well: <b>Karl E. Jennison</b> R.R. or street: City, state, zip code: <b>Healy, Kansas 67850</b>		
4. Locate with "X" in section below: N W E S 1 Mile		Sketch map: 		6. Bore hole dia. <b>20</b> in. Completion date <b>5/24/79</b> Well depth <b>175</b> ft.	
5. Type and color of material		From		To	
clay		0		20	
gyp		20		47	
fine sand		47		56	
sand		56		65	
clay		65		72	
rock		72		80	
clay		80		84	
rock		84		95	
fine sand		95		112	
sand		112		126	
fine sand		126		147	
clay		147		156	
fine sand		156		168	
sand		168		174	
clay yellow		174		179	
(Use a second sheet if needed)					
18. Elevation:	19. Remarks:		20. Water well contractor's certification: This well was drilled under my jurisdiction and this report is true to the best of my knowledge and belief. <b>Weishaar Drilling &amp; Supply 232</b> Business name License No. Address <b>Scott City, Kansas 67871</b> Signed <b>[Signature]</b> Date <b>5/24/79</b> Authorized representative		

Forward the white, blue and pink copies to the Department of Health and Environment

Form WWC-5