

Scott

WATER WELL PLUGGING RECORD Form WWC-5P KSA 82a-1212 ID NO.

[Empty box for ID number]


1 LOCATION OF WATER WELL: County: Lane Fraction: SW 1/4 NE 1/4 NE 1/4 Section Number: B 22 Township Number: 17 Range Number: 30 E(W)

Distance and direction from nearest town or city street address of well if located within city?

2 miles south of Hwy 4 on Dodge Rd, 1/2 miles west on Rd 210 and 191 ft south of Rd 210

2 WATER WELL OWNER: David & Debi Scott RR#, St. Address, Box #: 84 W. Rd 210 City, State ZIP Code: Healy, Ks. 67850 Global Positioning Systems (decimal degrees, min. of 4 digits) Latitude: Longitude: Elevation: Datum: Data Collection Method:

3 MARK WELL'S LOCATION WITH AN "X" IN SECTION BOX:

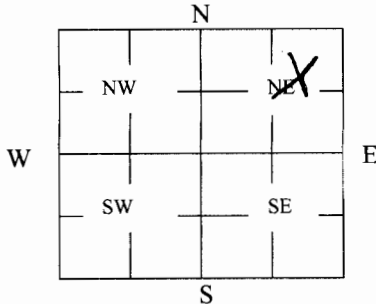

4 DEPTH OF WELL 10 ft.

WELL'S STATIC WATER LEVEL None ft

WELL WAS USED AS:

- 1 Domestic 2 Irrigation 3 Feedlot 4 Industrial 5 Public Water Supply 6 Oil Field Water Supply 7 Domestic (Lawn & Garden) 8 Air Conditioning 9 Dewatering 10 Monitoring 11 Injection Well 12 Other

Was a chemical/bacteriological sample submitted to Department? Yes No X

5 TYPE OF BLANK CASING USED: 1 Steel 2 PVC 3 RMP (SR) 4 ABS 5 Wrought 6 Asbestos-Cement 7 Fiberglass 8 Concrete Tile 9 Other (Specify below)

Blank casing diameter 5 1/2 in. Was casing pulled? Yes No X If yes, how much Casing height above or below land surface 20 in. above

6 GROUT PLUG MATERIAL: 1 Neat cement 2 Cement grout 3 Bentonite 4 Other

Grout Plug Intervals: From ft. to ft., From ft. to ft., From to ft.

What is the nearest source of possible contamination:

- 1 Septic tank 2 Sewer lines 3 Watertight sewer lines 4 Lateral lines 5 Cess pool 6 Seepage pit 7 Pit privy 8 Sewage lagoon 9 Feedyard 10 Livestock pens 11 Fuel Storage 12 Fertilizer storage 13 Insecticide storage 14 Abandoned water well 15 Oil well/Gas well 16 Other (specify below)

Table with columns: FROM, TO, PLUGGING MATERIALS. Rows: 10' deep to 6' deep (subsoil 16 cu ft), 6' deep to 3' deep (bentonite plug 1 bag), 3' deep to 0' top (topsoil 16 cu ft).

7 CONTRACTOR'S OR LANDOWNER'S CERTIFICATION: This water well was plugged under my jurisdiction and was completed on (mo/day/year) 5-18-2012 and this record is true to the best of my knowledge and belief. Kansas Water Well Contractor's License No. This Water Well Record was completed on (mo/day/year) 5-18-2012 under the business name of David Scott by (signature) David Scott

INSTRUCTIONS: Use typewriter or ballpoint pen. Please press firmly and print clearly. Please fill in blanks, underline or circle the correct answers. Send top three copies to Kansas Department of Health and Environment, Bureau of Water, Geology Section, 1000 SW Jackson St., Ste. 420, Topeka, Kansas 66612-1367. Telephone: 785/296-5522. Send one to Water Well Owner and retain one for your records. Visit us at http://www.kdheks.gov/geo/waterwells.