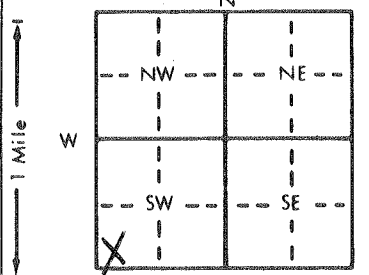


1 LOCATION OF WATER WELL: Fraction SW 1/4 SW 1/4 SW 1/4 Section Number 1 Township Number T 17 S Range Number R 21 31 EW
 County: Scott Scott

Distance and direction from nearest town or city street address of well if located within city?
12 Miles West, 6 Miles South, 1 Mile East of Healy Ks.

2 WATER WELL OWNER: Robert Hoeme Abercrombie Drilling
 RR#, St. Address, Box #: Scott City, Ks. 67871 150 Main Suite 801 Board of Agriculture, Division of Water Resources
 City, State, ZIP Code: Wichita, Ks. 6720201383 Application Number: 950202

3 LOCATE WELL'S LOCATION WITH AN "X" IN SECTION BOX:

 4 DEPTH OF COMPLETED WELL: 172 ft. ELEVATION: _____
 Depth(s) Groundwater Encountered 1. 118 ft. 2. _____ ft. 3. _____ ft.
 WELL'S STATIC WATER LEVEL: 118 ft. below land surface measured on mo/day/yr _____
 Pump test data: Well water was _____ ft. after _____ hours pumping _____ gpm
 Est. Yield _____ gpm: Well water was _____ ft. after _____ hours pumping _____ gpm
 Bore Hole Diameter: 8 in. to 172 ft. and _____ in. to _____ ft.
 WELL WATER TO BE USED AS:
 5 Public water supply 8 Air conditioning 11 Injection well
 1 Domestic 3 Feedlot 6 Oil field water supply 9 Dewatering 12 Other (Specify below)
 2 Irrigation 4 Industrial 7 Lawn and garden only 10 Monitoring well _____
 Was a chemical/bacteriological sample submitted to Department? Yes _____ No X _____; If yes, mo/day/yr sample was submitted _____
 Water Well Disinfected? Yes _____ No X _____

5 TYPE OF BLANK CASING USED:
 1 Steel 3 RMP (SR) 5 Wrought iron 8 Concrete tile CASING JOINTS: Glued X Clamped _____
 2 PVC 4 ABS 6 Asbestos-Cement 9 Other (specify below) Welded _____
 7 Fiberglass Threaded _____
 Blank casing diameter 4.5 in. to 132 ft. Dia _____ in. to _____ ft. Dia _____ in. to _____ ft.
 Casing height above land surface: 18 in., weight 2.38 lbs./ft. Wall thickness or gauge No. 248
 TYPE OF SCREEN OR PERFORATION MATERIAL:
 1 Steel 3 Stainless steel 5 Fiberglass 7 PVC 10 Asbestos-cement
 2 Brass 4 Galvanized steel 6 Concrete tile 8 RMP (SR) 11 Other (specify) _____
 9 ABS 12 None used (open hole)
 SCREEN OR PERFORATION OPENINGS ARE:
 1 Continuous slot 3 Mill slot 5 Gauzed wrapped 8 Saw cut 11 None (open hole)
 2 Louvered shutter 4 Key punched 6 Wire wrapped 9 Drilled holes
 7 Torch cut 10 Other (specify) _____
 SCREEN-PERFORATED INTERVALS: From 132 ft. to 172 ft., From _____ ft. to _____ ft.
 From _____ ft. to _____ ft., From _____ ft. to _____ ft.
 GRAVEL PACK INTERVALS: From 20 ft. to 172 ft., From _____ ft. to _____ ft.
 From _____ ft. to _____ ft., From _____ ft. to _____ ft.

6 GROUT MATERIAL: 1 Neat cement 2 Cement grout 3 Bentonite 4 Other _____
 Grout Intervals: From 0 ft. to 20 ft., From _____ ft. to _____ ft., From _____ ft. to _____ ft.
 What is the nearest source of possible contamination:
 1 Septic tank 4 Lateral lines 7 Pit privy 10 Livestock pens 14 Abandoned water well
 2 Sewer lines 5 Cess pool 8 Sewage lagoon 11 Fuel storage 15 Oil well/Gas well
 3 Watertight sewer lines 6 Seepage pit 9 Feedyard 12 Fertilizer storage 16 Other (specify below)
 13 Insecticide storage _____
 Direction from well? South How many feet? 100'

FROM	TO	LITHOLOGIC LOG	FROM	TO	PLUGGING INTERVALS
0	2	Surface	163	167	Fine Sand
2	18	Loess	167	172	Shale
18	34	Clay w/Caliche Strks.			
34	45	Clay, Caliche & Sand Mix			
45	68	Med. Sand w/a few Clay Strks.			
68	71	Cemented Sand w/Med. Sand Strks.			
71	77.5	Med. Sand & Gravel w/a Few Fine			
77.5	78	Cemented Sand Clay Lns.			
78	102	Med. Sand & Gravel			
102	106	Tight Fine Sand			
106	110	Fine to Med. Sand w/a Few Clay Strks			
110	123	Med. Sand & Gravel w/Some Clay			
123	126	Tight Sand			
126	138	Med. Sand & Gravel w/a Few Clay Str			
138	163	Fine to Med. Sand w/Clay Strks.			

7 CONTRACTOR'S OR LANDOWNER'S CERTIFICATION: This water well was (1) constructed, (2) reconstructed, or (3) plugged under my jurisdiction and completed on (mo/day/year) 7-12-95 and this record is true to the best of my knowledge and belief. Kansas Water Well Contractor's License No. 554 This Water Well Record was completed on (mo/day/yr) 7-12-95 under the business name of Woofter Pump & Well, Inc. by (signature) [Signature]