


WATER WELL RECORD

Form WWC-5

Division of Water Resources App. No.

1 LOCATION OF WATER WELL: County: Scott, Fraction 1/4 SE 1/4 SE 1/4 NE 1/4, Section Number 30, Township No. T 17 S, Range Number R 31. Global Positioning System (GPS) information: Latitude: ..., Longitude: ..., Elevation: ...

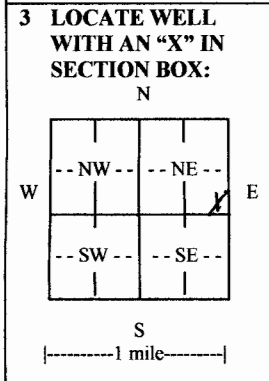

2 WATER WELL OWNER: Oil Producers Inc. of Kansas, RR#, Street Address, Box #: 1710 Waterfront Parkway, City, State, ZIP Code: Wichita, Kansas 67206. 3 LOCATE WELL WITH AN 'X' IN SECTION BOX: [Diagram]. 4 DEPTH OF COMPLETED WELL: 175 ft. Depth(s) Groundwater Encountered (1) 142 ft. WELL'S STATIC WATER LEVEL 142 ft. below land surface measured on mo/day/yr. 8/5/09.

5 TYPE OF CASING USED: Steel, PVC, Other. CASING JOINTS: Glued, Clamped, Welded, Threaded. Casing diameter 5 in. to 175 ft., Diameter in. to ft., Diameter in. to ft. Casing height above land surface 18 in., Weight 200 lbs./ft., Wall thickness or gauge No. SDR21. TYPE OF SCREEN OR PERFORATION MATERIAL: Steel, Stainless Steel, PVC, Brass, Galvanized Steel, None used (open hole). SCREEN OR PERFORATION OPENINGS ARE: Continuous slot, Mill slot, Gauze wrapped, Torch cut, Drilled holes, None (open hole), Louvered shutter, Key punched, Wire wrapped, Saw cut, Other (specify). SCREEN-PERFORATED INTERVALS: From 135 ft. to 175 ft., From ft. to ft., From ft. to ft. GRAVEL PACK INTERVALS: From 20 ft. to 175 ft., From ft. to ft., From ft. to ft.

6 GROUT MATERIAL: Neat cement, Cement grout, Bentonite, Other. Grout intervals: From 0 ft. to 20 ft., From ft. to ft., From ft. to ft., From ft. to ft. What is the nearest source of possible contamination: Septic tank, Lateral lines, Pit privy, Livestock pens, Insecticide storage, Other (specify below), Sewer lines, Cesspool, Sewage lagoon, Fuel storage, Abandoned water well, Watertight sewer lines, Seepage pit, Feedyard, Fertilizer storage, Oil well/gas well, None Known. Direction from well, Distance from well.

Table with columns FROM, TO, LITHOLOGIC LOG, FROM, TO, LITHO. LOG (cont.) or PLUGGING INTERVALS. Rows include Topsoil, Brown Clay, Coarse Sand Small Gravel, Cemented Sand Few Loose Streaks, Coarse Sand Small Gravel Loose, Gypsum, Coarse Sand w/ Clay Streaks, Medium Sand Loose, Medium Sand few Small Clay Streaks, Med to Coarse San Small Gravel.

7 CONTRACTOR'S OR LANDOWNER'S CERTIFICATION: This water well was constructed, reconstructed, or plugged under my jurisdiction and was completed on (mo/day/year) 8/5/09 and this record is true to the best of my knowledge and belief. Kansas Water Well Contractor's License No. 532. This Water Well Record was completed on (mo/day/year) 8/29/09 under the business name of Midwest Well & Pump, Inc. by (signature).

INSTRUCTIONS: Use typewriter or ball point pen. PLEASE PRESS FIRMLY and PRINT clearly. Please fill in blanks and check the correct answers. Send three copies (white, blue, pink) to Kansas Department of Health and Environment, Bureau of Water, Geology Section, 1000 SW Jackson St., Suite 420, Topeka, Kansas 66612-1367. Telephone 785-296-5522. Send one copy to WATER WELL OWNER and retain one for your records. Include fee of \$5.00 for each constructed well. Visit us at http://www.kdheks.gov/waterwell/index.html.