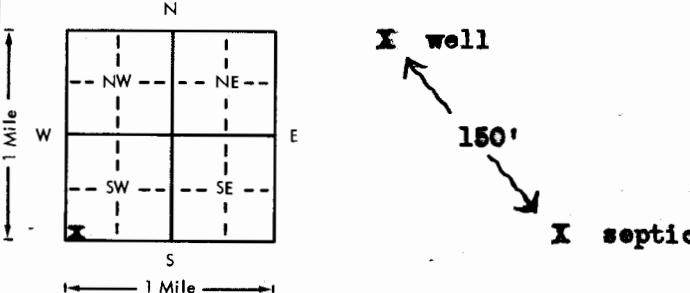


USE TYPEWRITER OR BALL POINT PEN-PRESS FIRMLY, PRINT CLEARLY.

WATER WELL RECORD
KSA 82a-1201-1215

Kansas Department of Health and Environment-Division of Environment
(Water well Contractors)
Topeka, Kansas 66620

1. Location of well:	County Scott	Fraction S/W 1/4 S/W 1/4 S/W 1/4	Section number 6	Township number T 17 S R 31 4/W	Range number
2. Distance and direction from nearest town or city: Street address of well location if in city: S.W., 6E. of Scott City, Kansas			3. Owner of well: R.R. or street: City, state, zip code: Elmer Wilson RFD # 1 Scott City, Kansas 67871		
4. Locate with "X" in section below: Sketch map: 			6. Bore hole dia. <u>5</u> in. Completion date <u>5/18/1978</u> Well depth <u>205</u> ft.		
5. Type and color of material			7. <input checked="" type="checkbox"/> Cable tool <input checked="" type="checkbox"/> Rotary <input type="checkbox"/> Driven <input type="checkbox"/> Dug <input type="checkbox"/> Hollow rod <input type="checkbox"/> Jetted <input type="checkbox"/> Bored <input type="checkbox"/> Reverse rotary		
			8. Use: <input checked="" type="checkbox"/> Domestic <input type="checkbox"/> Public supply <input type="checkbox"/> Industry <input type="checkbox"/> Irrigation <input type="checkbox"/> Air conditioning <input type="checkbox"/> Stock <input type="checkbox"/> Lawn <input type="checkbox"/> Oil field water <input type="checkbox"/> Other		
			9. Casing: Material <u>Plastic</u> Weight: Above or below Threaded <input type="checkbox"/> Welded <input checked="" type="checkbox"/> glns Surface <u>12</u> in. RMP <input checked="" type="checkbox"/> PVC <input type="checkbox"/> Weight <u>1.8</u> lbs./ft. Dia. <u>5</u> in. to <u>185</u> ft. depth Wall Thickness: inches or Dia. <u>5</u> in. to <u>205</u> ft. depth Gage No. <u>250</u>		
			10. Screen: Manufacturer's name Jess & Lowell Type <u>RMP</u> Dia. <u>5"</u> Slot/gauze <u>1/16"</u> Length <u>20'</u> Set between <u>185</u> ft. and <u>205</u> ft. ft. and _____ ft. Gravel pack? <u>yes</u> Size range of material <u>1/8" to 3/4"</u>		
			11. Static water level: _____ mg./day/yr. <u>128</u> ft. below land surface Date <u>5/5/1978</u>		
			12. Pumping level below land surfaces: <u>140</u> ft. after <u>2</u> hrs. pumping <u>10</u> g.p.m. _____ ft. after _____ hrs. pumping _____ g.p.m. Estimated maximum yield <u>10</u> g.p.m.		
			13. Water sample submitted: _____ mo./day/yr. Yes <input type="checkbox"/> No <input checked="" type="checkbox"/> Date _____		
			14. Well head completion: <input checked="" type="checkbox"/> Pitless adapter <u>12</u> Inches above grade		
			15. Well grouted? <u>yes</u> With: <input checked="" type="checkbox"/> Neat cement <input type="checkbox"/> Bentonite <input type="checkbox"/> Concrete Depth: From <u>0</u> ft. to <u>15</u> ft.		
			16. Nearest source of possible contamination: ft. <u>150</u> Direction <u>S/E</u> Type <u>septic</u> Well disinfected upon completion? <input checked="" type="checkbox"/> Yes <input type="checkbox"/> No		
			17. Pump: _____ Not installed Manufacturer's name <u>Red Jacket</u> Model number <u>H12BC</u> HP <u>3/4</u> Volt <u>230</u> Length of drop pipe <u>195</u> ft. capacity <u>10</u> g.p.m. Type: <input checked="" type="checkbox"/> Submersible <input type="checkbox"/> Turbine <input type="checkbox"/> Jet <input type="checkbox"/> Reciprocating <input type="checkbox"/> Centrifugal <input type="checkbox"/> Other		
18. Elevation:			20. Water well contractor's certification: This well was drilled under my jurisdiction and this report is true to the best of my knowledge and belief. Weishar Drilling & Sup. 232 Business name _____ License No. _____ Address <u>Scott City, KS 67871</u> Signed <u>[Signature]</u> Date <u>5/25/78</u> Authorized Representative		
19. Remarks:					
Topography: <input type="checkbox"/> Hill <input checked="" type="checkbox"/> Slope <input type="checkbox"/> Upland <input type="checkbox"/> Valley					

17 31 W 6 SWSWSID

Forward the white, blue and pink copies to the Department of Health and Environment

Form WWC-5