


1 LOCATION OF WATER WELL: Fraction SE 1/4 SW 1/4 NW 1/4 Section Number 32 Township Number T 17 S Range Number R 31 E/W

Distance and direction from nearest town or city street address of well if located within city?
7 miles East 3 1/2 miles North of Scott City, Kansas

2 WATER WELL OWNER: Delmar Huck
 RR#, St. Address, Box #: 701 Era Board of Agriculture, Division of Water Resource
 City, State, ZIP Code: Scott City, Kansas 67871 Application Number:

3 LOCATE WELL'S LOCATION WITH AN "X" IN SECTION BOX:

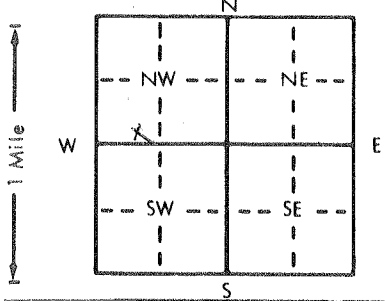

4 DEPTH OF COMPLETED WELL: 175 ft. ELEVATION:
 Depth(s) Groundwater Encountered 1. 114 ft. 2. ft. 3. ft.
 WELL'S STATIC WATER LEVEL 114 ft. below land surface measured on mo/day/yr 10/27/83
 NA Pump test data: Well water was ft. after hours pumping gpm
 Est. Yield gpm: Well water was ft. after hours pumping gpm
 Bore Hole Diameter: 9 in. to 175 ft., and in. to ft.
 WELL WATER TO BE USED AS: 5 Public water supply 8 Air conditioning 11 Injection well
 Domestic 3 Feedlot 6 Oil field water supply 9 Dewatering Other (Specify below)
 Irrigation 4 Industrial 7 Lawn and garden only 10 Observation well Stockwell
 Was a chemical/bacteriological sample submitted to Department? Yes.....No; If yes, mo/day/yr sample was submitted
 Water Well Disinfected? Yes No

5 TYPE OF BLANK CASING USED: 5 Wrought iron 8 Concrete tile CASING JOINTS: Glued Clamped
 1 Steel 3 RMP (SR) 6 Asbestos-Cement 9 Other (specify below) Welded
 PVC 4 ABS 7 Fiberglass Threaded
 Blank casing diameter 5 in. to 155 ft., Dia in. to ft., Dia in. to ft.
 Casing height above land surface 12 in., weight 2.9 lbs./ft. Wall thickness or gauge No. 265

TYPE OF SCREEN OR PERFORATION MATERIAL: 7 PVC 10 Asbestos-cement
 1 Steel 3 Stainless steel 5 Fiberglass 8 RMP (SR) 11 Other (specify)
 2 Brass 4 Galvanized steel 6 Concrete tile 9 ABS 12 None used (open hole)

SCREEN OR PERFORATION OPENINGS ARE: 5 Gauzed wrapped 8 Saw cut 11 None (open hole)
 1 Continuous slot 3 Mill slot 6 Wire wrapped 9 Drilled holes
 2 Louvered shutter 4 Key punched 7 Torch cut 10 Other (specify)

SCREEN-PERFORATED INTERVALS: From 155 ft. to 175 ft., From ft. to ft.
 From ft. to ft., From ft. to ft.
 GRAVEL PACK INTERVALS: From 130 ft. to 175 ft., From ft. to ft.
 From ft. to ft., From ft. to ft.

6 GROUT MATERIAL: 1 Neat cement 2 Cement grout 3 Bentonite 4 Other Drill cuttings
 Grout Intervals: From 15 ft. to 130 ft., From 4 ft. to 15 ft., From ft. to ft.
 What is the nearest source of possible contamination:
 1 Septic tank 4 Lateral lines 7 Pit privy 10 Livestock pens 14 Abandoned water well
 2 Sewer lines 5 Cess pool 8 Sewage lagoon 11 Fuel storage 15 Oil well/Gas well
 3 Watertight sewer lines 6 Seepage pit 9 Feedyard 12 Fertilizer storage 16 Other (specify below)
 13 Insecticide storage

Direction from well? North How many feet? 2600

FROM	TO	LITHOLOGIC LOG	FROM	TO	LITHOLOGIC LOG
0	32	Clay	32	36	Caliche
36	42	Sand rock	42	51	Clay
51	75	Sand medium	75	140	Sand
140	167	Fine Sand	167	170	Sand & gravel
170	173	Yellow clay	173	175	Shale

7 CONTRACTOR'S OR LANDOWNER'S CERTIFICATION: This water well was (1) constructed (2) reconstructed, or (3) plugged under my jurisdiction and was completed on (mo/day/year) 10/28/83 and this record is true to the best of my knowledge and belief. Kansas Water Well Contractor's License No. 232 This Water Well Record was completed on (mo/day/yr) 10/31/83 under the business name of Weishaar Drilling & Supply Inc. by signature [Signature]
 INSTRUCTIONS: Use typewriter or ball point pen, PLEASE PRESS FIRMLY and PRINT clearly. Please fill in blanks, underline or circle the correct answers. Send top three copies to Kansas Department of Health and Environment, Division of Environment, Environmental Geology Section, Topeka, KS 66620. Send one to WATER WELL OWNER and retain one for your records.