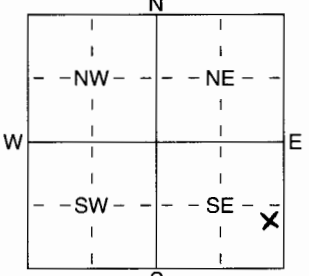


1 LOCATION OF WATER WELL:		Fraction	Section Number	Township Number	Range Number
County: <u>Scott</u>		<u>NE 1/4 SE 1/4 SE 1/4</u>	<u>22</u>	T <u>17</u> S	R <u>32</u> <u>EW</u>
Distance and direction from nearest town or city street address of well if located within city?					
2 WATER WELL OWNER: <u>Brookover Cattle Co.</u>					
RR#, St. Address, Box # : <u>4000 E. Road 200</u>				Board of Agriculture, Division of Water Resources	
City, State, ZIP Code : <u>Scott City, KS 67871</u>				Application Number:	
3 LOCATE WELL'S LOCATION WITH		4 DEPTH OF COMPLETED WELL <u>179</u> ft. ELEVATION:			
AN "X" IN SECTION BOX:		Depth(s) Groundwater Encountered 1 ft. 2 ft. 3 ft. WELL'S STATIC WATER LEVEL <u>135'6"</u> ft. below land surface measured on mo/day/yr <u>4-4-05</u> Pump test data: Well water was ft. after hours pumping gpm Est. Yield <u>10</u> gpm: Well water was ft. after hours pumping gpm WELL WATER TO BE USED AS: 5 Public water supply 8 Air conditioning 11 Injection well 1 Domestic 3 Feedlot 6 Oil field water supply 9 Dewatering 12 Other (Specify below) 2 Irrigation 4 Industrial 7 Domestic (lawn & garden) 10 Monitoring well <u>stock</u>			
		Was a chemical/bacteriological sample submitted to Department? Yes No <u>✓</u> If yes, mo/day/yr sample was submitted Water Well Disinfected? <u>Yes</u> No			
5 TYPE OF BLANK CASING USED:					
1 Steel 2 PVC 3 RMP (SR) 4 ABS		5 Wrought iron 6 Asbestos-Cement 7 Fiberglass		8 Concrete tile 9 Other (specify below) CASING JOINTS: Glued Clamped Welded Threaded	
Blank casing diameter <u>12</u> in. to <u>179</u> ft. Dia in. to ft. Dia in. to ft.					
Casing height above land surface <u>12</u> in., weight lbs./ft. Wall thickness or gauge No. <u>200 p.s.i.</u>					
TYPE OF SCREEN OR PERFORATION MATERIAL:					
1 Steel 2 Brass 3 Stainless Steel 4 Galvanized Steel		5 Fiberglass 6 Concrete tile 7 Torch cut		8 PVC 8 RMP (SR) 9 ABS 10 Asbestos-Cement 11 Other (Specify) 12 None used (open hole)	
SCREEN OR PERFORATION OPENINGS ARE:					
1 Continuous slot 2 Louvered shutter 3 Mill slot 4 Key punched		5 Gauzed wrapped 6 Wire wrapped 7 Torch cut		8 Saw cut 9 Drilled holes 10 Other (specify) ft. 11 None (open hole)	
SCREEN-PERFORATED INTERVALS: From <u>139</u> ft. to <u>179</u> ft., From ft. to ft.					
GRAVEL PACK INTERVALS: From <u>25</u> ft. to <u>179</u> ft., From ft. to ft.					
6 GROUT MATERIAL: 1 Neat cement 2 Cement grout 3 Bentonite 4 Other					
Grout Intervals: From <u>5</u> ft. to <u>25</u> ft., From ft. to ft., From ft. to ft.					
What is the nearest source of possible contamination:					
1 Septic tank 2 Sewer lines 3 Watertight sewer lines		4 Lateral lines 5 Cess pool 6 Seepage pit		7 Livestock pens 7 Pit privy 8 Sewage lagoon 9 Feedyard 10 Fuel storage 11 Fertilizer storage 12 Insecticide storage	
				13 Abandoned water well 14 Oil well/Gas well 15 Other (specify below)	
Direction from well? How many feet? <u>500</u>					
FROM	TO	LITHOLOGIC LOG	FROM	TO	PLUGGING INTERVALS
0	2	top soil			
2	27	brown clay			
27	45	gypsum			
45	62	fine, med sand, hard cemented streaks			
62	86	medium to coarse sand, small gravel			
86	88	brown clay			
88	112	gypsum & cemented sand			
112	114	fine sand			
114	120	brown clay			
120	140	fine to medium sand, loose			
140	142	cemented sand			
142	169	fine to medium sand, loose			
169	180	brown clay, sand streaks			
180	182	yellow shale			
		182- black shale			
7 CONTRACTOR'S OR LANDOWNER'S CERTIFICATION: This water well was 1 constructed, (2) reconstructed, or (3) plugged under my jurisdiction and was completed on (mo/day/year) <u>4-4-05</u> and this record is true to the best of my knowledge and belief. Kansas Water Well Contractor's Licence No <u>532</u> This Water Well Record was completed on (mo/day/yr) <u>4-27-05</u> under the business name of <u>Midwest Well & Pump Inc.</u> by (signature) <u>Nector Jankup</u>					
INSTRUCTIONS: Use typewriter or ball point pen. PLEASE PRESS FIRMLY and PRINT clearly. Please fill in blanks, underline or circle the correct answers. Send top three copies to Kansas Department of Health and Environment, Bureau of Water, Geology Section, 1000 SW Jackson St., Suite 420, Topeka, Kansas 66612-1367. Telephone 785-296-5522. Send one to WATER WELL OWNER and retain one for your records. Fee of \$5.00 for each constructed well.					