

## WATER WELL PLUGGING RECORD Form WWC-5P

KSA 82a-1212

ID NO.

1 LOCATION OF WATER WELL: County: <b>Scott</b>	Fraction <b>¼ SE ¼ SW ¼ SW ¼</b>	Section Number <b>30</b>	Township Number <b>17 T S</b>	Range Number <b>32</b> <input type="checkbox"/> E <input checked="" type="checkbox"/> W
---	-------------------------------------	-----------------------------	----------------------------------	--

Street/Rural Address of Well Location: if unknown, distance & direction from nearest town or intersection: If at owner's address, check here ☐ 83 Hwy & 96 Hwy 4 Miles North, 1/2 Mile East, North 300'

## Global Positioning Systems (GPS) information:

Latitude: \_\_\_\_\_ (in decimal degrees)

Longitude: \_\_\_\_\_ (in decimal degrees)

Elevation: \_\_\_\_\_

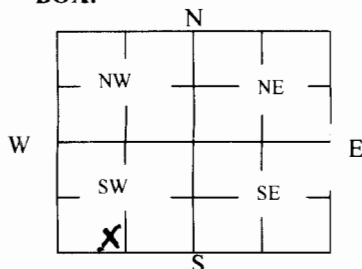
Horizontal Datum: ☐ WGS84, ☐ NAD83, ☐ NAD27

Collection Method: \_\_\_\_\_

2 WATER WELL OWNER: **Wiechman Land & Cattle**  
RR#, St. Address, Box #: **4030 N. Hwy 83**  
City, State ZIP Code: **Scott City, KS 67871**

☐ GPS unit (Make/Model: \_\_\_\_\_)☐ Digital Map/Photo, ☐ Topographic Map, ☐ Land SurveyEst. Accuracy: ☐ < 3 m, ☐ 3-5 m, ☐ 5-15 m, ☐ > 15 m

## 3 MARK WELL'S LOCATION WITH AN "X" IN SECTION BOX:

4 DEPTH OF WELL **267'** ft.WELL'S STATIC WATER LEVEL **179'** ft

WELL WAS USED AS:

☐ Domestic  
☒ Irrigation  
☐ Feedlot  
☐ Industrial

☐ Public Water Supply  
☐ Oil Field Water Supply  
☐ Domestic (Lawn & Garden)  
☐ Air Conditioning

☐ Dewatering  
☐ Monitoring  
☐ Injection Well  
☐ Other \_\_\_\_\_
Was a chemical/bacteriological sample submitted to Department? Yes ☐ No ☒

## 5 TYPE OF BLANK CASING USED:

☒ Steel  
☐ PVC☐ RMP (SR)  
☐ ABS☐ Wrought  
☐ Asbestos-Cement☐ Fiberglass  
☐ Concrete Tile☐ Other (Specify below) \_\_\_\_\_

Blank casing diameter **16** in. Was casing pulled? Yes ☐ No ☒ If yes, how much \_\_\_\_\_  
 Casing height above or below land surface **48** in.

6 GROUT PLUG MATERIAL: ☐ Neat cement ☐ Cement grout ☒ Bentonite ☐ Other \_\_\_\_\_Grout Plug Intervals: From **4** ft. to **10** ft., From \_\_\_\_\_ ft. to \_\_\_\_\_ ft., From \_\_\_\_\_ ft. to \_\_\_\_\_ ft.

What is the nearest source of possible contamination:

☐ Septic tank  
☐ Sewer lines  
☐ Watertight sewer lines  
☐ Lateral lines  
☐ Cess pool

☐ Seepage pit  
☐ Pit privy  
☐ Sewage lagoon  
☐ Feedyard  
☒ Livestock pens

☐ Fuel storage  
☐ Fertilizer storage  
☐ Insecticide storage  
☐ Abandoned water well  
☐ Oil well/Gas well
☐ Other (specify below) \_\_\_\_\_Direction from well? **North**How many feet? **50'**

FROM	TO	PLUGGING MATERIALS	FROM	TO	PLUGGING MATERIALS
0	4	Top Soil			
4	10	Bentonite			
10	179	Sand, Gravel, Clay, Bentonite			
179	267	Washed Sand & Gravel			

7 CONTRACTOR'S OR LANDOWNER'S CERTIFICATION: This water well was plugged under my jurisdiction and was completed on (mo/day/year) **6-29-15** and this record is true to the best of my knowledge and belief. Kansas Water Well Contractor's License No. **532**. This Water Well Record was completed on (mo/day/year) **7-24-15** under the business name of **Midwest Well & Pump Inc.** by (signature) *[Signature]*

Send one white copy to Kansas Department of Health & Environment, Geology Section, 1000 SW Jackson Street, Ste. 420, Topeka, KS 66612-1367. Send one copy to WATER WELL OWNER and retain one for your records.

Visit us at <http://www.kdheks.gov/waterwell/index.html> Telephone 785-296-5524.

KSA82a-1212

Revised 1/20/2015