


WATER WELL RECORD Form WNC-5 KSA 82a-1212

1 LOCATION OF WATER WELL: Fraction Section Number Township Number Range Number  
 COUNTY: 086 SCOTT NW 1/4 NE 1/4 SW 1/4 05 T 17 S R 32 W

Distance and direction from nearest town or city street address of well if located within city?  
 APPROX. 7 1/2 MILES NORTH AND 1 MILE EAST OF SCOTT CITY.

2 WATER WELL OWNER: RICHARD CHRISTY Board of Agriculture, Division of Water Resources  
 RR#, St. Address, Box #: P.O. BOX 689  
 City, State, ZIP code: SCOTT CITY, KS 67871- Application Number: 19980

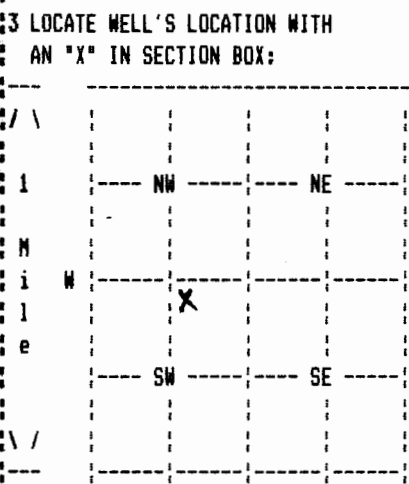

4 DEPTH OF COMPLETED WELL 220 ELEVATION: 0  
 Depth(s) Groundwater Encountered 1. 131 ft. 2. 0 ft. 3. 0 ft.  
 WELL'S STATIC WATER LEVEL 131 ft. below land surface measured on mo/day/yr 08/31/91  
 Pump testdata: Well water was 214 ft. after 4 hours pumping 390 gpm  
 Estimated Yield 350 gpm: Well water was 0 ft. after 0 hours pumping 0 gpm  
 Bore Hole Diameter 24 in. to 220 ft., and in. to 0 ft.  
 WELL WATER TO BE USED AS: 02 IRRIGATION  
 Was a chemical/bacteriological sample submitted to department? No;  
 If yes, mo/day/yr sample was submitted Water well disinfected? Yes

5 TYPE OF BLANK CASING USED: 01 STEEL CASING JOINTS: WELDED  
 Blank casing diameter 16 in. to 220 ft., Dia in. to 0 ft., Dia in. to 0 ft.  
 Casing height above land surface 12 in., weight 42 lbs/ft. Wall thickness or gauge No. .219  
 TYPE OF SCREEN OR PERFORATION MATERIAL: 01 STEEL  
 SCREEN OR PERFORATION OPENINGS ARE: 01 CONT. SLOT

SCREEN PERFORATED INTERVALS: From 16 ft. to 21 ft., From 0 ft. to 0 ft.  
 From 0 ft. to 0 ft., From 0 ft. to 0 ft.  
 GRAVEL PACK INTERVALS: From 20 ft. to 195 ft., From 0 ft. to 0 ft.  
 From 0 ft. to 0 ft., From 0 ft. to 0 ft.

6 GROUT MATERIAL 03 BENTONITE  
 Grout Intervals: From 0 ft. to 20 ft., From 0 ft. to 0 ft., From 0 ft. to 0 ft.  
 What is the nearest source of possible contamination: 14 ABAND. WELL  
 Direction from well? SOUTHWEST How many feet? 280

FROM	TO	LITHOLOGIC LOG	FROM	TO	PLUGGING INTERVALS
0	2	01 CLAY			
2	26	03 SILTY CLAY			
26	45	01 CLAY			
45	51	31 CALICHE			
51	59	08 MEDIUM SAND 01 CLAY 23 SANDSTONE			
59	76	31 CALICHE 20 LIMESTONE			
76	84	04 SANDY CLAY			
84	118	23 SANDSTONE 01 CLAY 20 LIMESTONE			
118	134	08 MEDIUM SAND 01 CLAY 23 SANDSTONE			
134	138	07 FINE SAND 08 MEDIUM SAND 23 SANDSTONE			

7 CONTRACTOR'S OR LANDOWNER'S CERTIFICATION: This water well was Constructed under my jurisdiction and was completed on (mo/day/year) 08/28/91 and this record is true to the best of my knowledge and belief. Kansas Water Well Contractor's License No. 145 This Water Well Record was completed on (mo/day/yr) 10/15/91 under the business name of HENKLE DRILLING & SUPPLY by (signature) *Douglas B. Henkle*

(Continued)

WATER WELL RECORD Form WWC-5 KSA 82a-1212

1 LOCATION OF WATER WELL:	Fraction	Section Number	Township Number	Range Number
COUNTY: 086 SCOTT	NW 1/4 NE 1/4 SW 1/4	05	T 17 S	R 32 W

2 WATER WELL OWNER: RICHARD CHRISTY  
 RR#, St. Address, Box #: P.O. BOX 689 Board of Agriculture, Division of Water Resources

City, State, ZIP code : SCOTT CITY, KS 67871- Application Number: 19980

FROM	TO	LITHOLOGIC LOG
138	141	04 SANDY CLAY
141	147	07 FINE SAND 08 MEDIUM SAND
147	163	04 SANDY CLAY 01 CLAY
163	173	07 FINE SAND 08 MEDIUM SAND 01 CLAY
173	181	07 FINE SAND 08 MEDIUM SAND 09 COARSE SAND
181	193	07 FINE SAND 08 MEDIUM SAND 09 COARSE SAND
193	198	01 CLAY
198	201	07 FINE SAND 08 MEDIUM SAND 09 COARSE SAND
203	212	08 MEDIUM SAND 14 MED GRAVEL 15 CRS GRAVEL
212	214	19 SHALE
214	215	19 SHALE

7 CONTRACTOR'S OR LANDOWNER'S CERTIFICATION: This water well was Constructed under my jurisdiction and was completed on (mo/day/year) 08/28/91 and this record is true to the best of my knowledge and belief. Kansas Water Well Contractor's License No. 145 This Water Well Record was completed on (mo/day/yr) 10/15/91 under the business name of HENKLE DRILLING & SUPPLY

by (signature) *Douglas B. Henkle*