

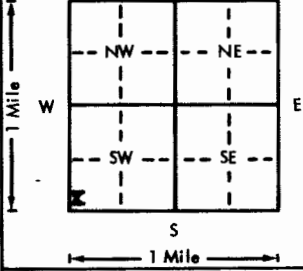
USE TYPEWRITER OR BALL
POINT PEN-PRESS FIRMLY,
PRINT CLEARLY.

LAKE SCOTT SE

CCC

WATER WELL RECORD
KSA 82a-1201-1215

Kansas Department of Health and
Environment-Division of Environment
(Water well Contractors)
Topeka, Kansas 66620

1. Location of well:		County Scott	Fraction SW 1/4 SW 1/4 SW 1/4	Section number 16	Township number T 17 S R	Range number 32/W
2. Distance and direction from nearest town or city: 4 mi south-1mi west of Pence, Ks. Street address of well location if in city:				3. Owner of well: Decker Bros Livestock (Larry Decker) R.R. or street: Box 96 Rte #3 City, state, zip code: Scott City, Ks. 67871		
4. Locate with "X" in section below:		Sketch map:		6. Bore hole dia. 24 in. Completion date 11-27-75 Well depth 181 ft.		
				7. <input checked="" type="checkbox"/> Cable tool <input checked="" type="checkbox"/> Rotary <input type="checkbox"/> Driven <input type="checkbox"/> Dug <input type="checkbox"/> Hollow rod <input type="checkbox"/> Jetted <input type="checkbox"/> Bored <input type="checkbox"/> Reverse rotary		
5. Type and color of material		From		To		8. Use: <input type="checkbox"/> Domestic <input type="checkbox"/> Public supply <input type="checkbox"/> Industry <input checked="" type="checkbox"/> Irrigation <input type="checkbox"/> Air conditioning <input type="checkbox"/> Stock <input type="checkbox"/> Lawn <input type="checkbox"/> Oil field water <input type="checkbox"/> Other
Clay, sand, gyp		0		20		9. Casing: Material Steel Height: Above or below Threaded <input type="checkbox"/> Welded <input checked="" type="checkbox"/> Surface 12 in. RMP <input type="checkbox"/> PVC <input type="checkbox"/> Weight 36.86 lbs./ft. Dia 46 in. to 181 ft. depth Wall Thickness: inches or Dia. <input type="checkbox"/> in. to <input type="checkbox"/> ft. depth gage No. 219
Sandy clay		20		80		10. Screen: Manufacturer's name Lakewood Type Millslot Dia. 16 Slot/gauze 1/8 Length 2 Set between 80 ft. and 181 ft. ft. and <input type="checkbox"/> ft. Gravel pack? <input checked="" type="checkbox"/> Size range of material 3x5/8
Sand, clay streaks		80		100		11. Static water level: <input type="checkbox"/> mo./day/yr. 83 ft. below land surface Date 11-27-75
Fine sand, few clay balls 15		100		120		12. Pumping level below land surfaces: 83 ft. after 5 hrs. pumping 300 g.p.m. ft. after <input type="checkbox"/> hrs. pumping <input type="checkbox"/> g.p.m. Estimated maximum yield 300 g.p.m.
Finesand, clay 5		120		140		13. Water sample submitted: <input type="checkbox"/> Yes <input checked="" type="checkbox"/> No Date <input type="checkbox"/> mo./day/yr.
Yellow clay, sand, gravel 10		140		160		14. Well head completion: <input type="checkbox"/> Pitless adapter 12 inches above grade
Sand, gravel, (loose), yellow clay 5		160		180		15. Well grouted? Yes With: <input checked="" type="checkbox"/> Neat cement <input type="checkbox"/> Bentonite <input type="checkbox"/> Concrete Depth: From 0 ft. to 10 ft.
Shale		180		180		16. Nearest source of possible contamination: NA ft. <input type="checkbox"/> Direction <input type="checkbox"/> Type <input type="checkbox"/> Well disinfected upon completion? <input type="checkbox"/> Yes <input type="checkbox"/> No
Ordered-Install later around first week in						17. Pump: <input checked="" type="checkbox"/> Not installed Manufacturer's name Worthington Model number 48-101-30 HP <input type="checkbox"/> Volts <input type="checkbox"/> Length of drop pipe <input type="checkbox"/> ft. capacity 300 g.p.m. Type: <input type="checkbox"/> Submersible <input checked="" type="checkbox"/> Turbine <input type="checkbox"/> Jet <input type="checkbox"/> Reciprocating <input type="checkbox"/> Centrifugal <input type="checkbox"/> Other
Feb January if possible						20. Water well contractor's certification: This well was drilled under my jurisdiction and this report is true to the best of my knowledge and belief. High Plains Drilling I Supply, Inc. 136 Business name High Plains Drilling I Supply, Inc. License No. 136 Address 402 N 3rd, Garden City, Ks. Signed Wladimir E. Shukron Date 12-25-75 Secretary Representative
18. Elevation:		19. Remarks:				
Topography: <input type="checkbox"/> Hill <input type="checkbox"/> Slope <input checked="" type="checkbox"/> Upland <input type="checkbox"/> Valley		2986 (TOPO)				

Forward the white, blue and pink copies to the Department of Health and Environment

Form WWC-5