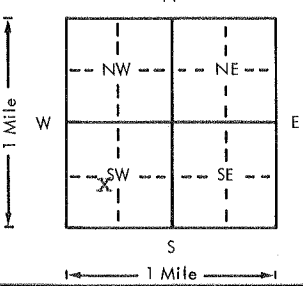



USE TYPEWRITER OR BALL
POINT PEN-PRESS FIRMLY,
PRINT CLEARLY.

WATER WELL RECORD
KSA 82a-1201-1215

Kansas Department of Health and
Environment-Division of Environment
(Water well Contractors)
Topeka, Kansas 66620

1. Location of well:	County Scott	Fraction NE 1/4 SW 1/4 SW 1/4	Section number 18	Township number T 17 S R 32 E	Range number 32	
2. Distance and direction from nearest town or city: 6 1/4 N, 1/4 E of		3. Owner of well: Donald Hayes R.R. or street: 1217 Field Court City, state, zip code: Naperville, Illinois 60540				
4. Locate with "X" in section below:		Sketch map: 		6. Bore hole dia. 26 in. Completion date Well depth 236 ft. 7-11-75		
5. Type and color of material		From	To	7. <input type="checkbox"/> Cable tool <input type="checkbox"/> Rotary <input type="checkbox"/> Driven <input type="checkbox"/> Dug <input type="checkbox"/> Hollow rod <input type="checkbox"/> Jetted <input checked="" type="checkbox"/> Bored <input checked="" type="checkbox"/> Reverse rotary		
Clay		0	73	8. Use: <input type="checkbox"/> Domestic <input type="checkbox"/> Public supply <input type="checkbox"/> Industry <input checked="" type="checkbox"/> Irrigation <input type="checkbox"/> Air conditioning <input type="checkbox"/> Stock <input type="checkbox"/> Lawn <input type="checkbox"/> Oil field water <input type="checkbox"/> Other		
Gyp		73	77	9. Casing: Material Steel Height: Above or below Threaded <input type="checkbox"/> Welded <input checked="" type="checkbox"/> Surface 10 in. RMP <input type="checkbox"/> PVC <input type="checkbox"/> Weight 31.62 lbs./ft. Dia. 16 in. to 236 ft. depth Wall Thickness: inches or Dia. <input type="checkbox"/> in. to <input type="checkbox"/> ft. depth gauge No. 188		
Clay		77	95	10. Screen: Manufacturer's name Free Flow Type Prime Steel Dia. 16 in. Clot/gauze .125 Length 60 ft. Set between 176 ft. and 236 ft. ft. and <input type="checkbox"/> ft.		
Gyp		95	100	Gravel pack? yes Size range of material 3/4 - 1/2		
Clay		100	107	11. Static water level: <input type="checkbox"/> mo./day/yr. 110 ft. below land surface Date 5-15-75		
Fine sd clay		107	119	12. Pumping level below land surfaces: 185 ft. after 4 hrs. pumping 500 g.p.m. 201 ft. after 4 hrs. pumping 520 g.p.m. Estimated maximum yield 520 g.p.m.		
Sd rock H		119	125	13. Water sample submitted: <input type="checkbox"/> mo./day/yr. Yes <input checked="" type="checkbox"/> No <input type="checkbox"/> Date <input type="checkbox"/>		
Fine sd clay		125	157	14. Well head completion: <input type="checkbox"/> Pitless adapter <input type="checkbox"/> Inches above grade		
Sd coarse		157	160	15. Well grouted? <input checked="" type="checkbox"/> With: <input checked="" type="checkbox"/> Neat cement <input type="checkbox"/> Bentonite <input type="checkbox"/> Concrete Depth: From 0 ft. to 10 ft.		
Fine sd clay		160	225	16. Nearest source of possible contamination: ft. 5280 Direction N Type Septic Well disinfected upon completion? <input checked="" type="checkbox"/> Yes <input type="checkbox"/> No		
Sd coarse		225	229	17. Pump: <input type="checkbox"/> Not installed Manufacturer's name Peerless Model number <input type="checkbox"/> HP <input type="checkbox"/> Volts <input type="checkbox"/> Length of drop pipe 225 ft. capacity 520 g.p.m. Type: <input type="checkbox"/> Submersible <input checked="" type="checkbox"/> Turbine <input type="checkbox"/> Jet <input type="checkbox"/> Reciprocating <input type="checkbox"/> Centrifugal <input type="checkbox"/> Other		
Clay		229	230	20. Water well contractor's certification: This well was drilled under my jurisdiction and this report is true to the best of my knowledge and belief. Weishaar Drilling 232 Business name Scott City, KS 67871 License No. Address Scott City, KS 67871 Signed  Date 7-20-76 Authorized representative		
Sd coarse		230	232			
Clay yellow		232	238			
Shale		238				
(Use a second sheet if needed)						
18. Elevation:	19. Remarks:					
Topography: <input type="checkbox"/> Hill <input type="checkbox"/> Slope <input checked="" type="checkbox"/> Upland <input type="checkbox"/> Valley						

Forward the white, blue and pink copies to the Department of Health and Environment

Form WWC-5