

1 LOCATION OF WATER WELL: County: <u>Scott</u>	Fraction <u>SW 1/4 NE 1/4 NW 1/4</u>	Section Number <u>23</u>	Township Number T <u>17</u> S	Range Number R <u>32</u> E/W <u>(W)</u>
---	---	-----------------------------	----------------------------------	--

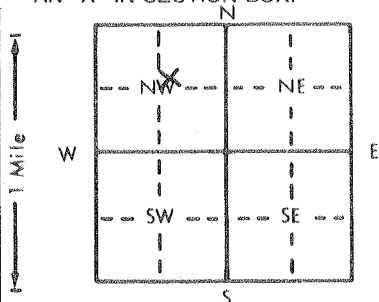
Distance and direction from nearest town or city street address of well if located within city?

4 1/2 miles north & 4 1/4 miles east of Scott City, KS.2 WATER WELL OWNER: Brookover Cattle Co.RR#, St. Address, Box #: Rt. #1 Box 98City, State, ZIP Code: Scott City, KS. 67871

Board of Agriculture, Division of Water Resource

Application Number: #40325

3 LOCATE WELL'S LOCATION WITH AN "X" IN SECTION BOX:

4 DEPTH OF COMPLETED WELL: 185 ft. ELEVATION:

Depth(s) Groundwater Encountered 1. ft. 2. ft. 3. ft.

WELL'S STATIC WATER LEVEL 135 ft. below land surface measured on mo/day/yr 9-25-92

Pump test data: Well water was ft. after hours pumping gpm

Est. Yield 135 gpm: Well water was ft. after hours pumping gpmBore Hole Diameter 26 in. to 185 ft., and in. to ft.

WELL WATER TO BE USED AS: 5 Public water supply 8 Air conditioning 11 Injection well

1 Domestic ☒ Feedlot 6 Oil field water supply 9 Dewatering 12 Other (Specify below)

2 Irrigation 4 Industrial 7 Lawn and garden only 10 Monitoring well

Was a chemical/bacteriological sample submitted to Department? Yes.....No ☒.....; If yes, mo/day/yr sample was submittedWater Well Disinfected? Yes ☒ No

5 TYPE OF BLANK CASING USED:

☒ Steel 3 RMP (SR)
2 PVC 4 ABS

5 Wrought iron

8 Concrete tile

CASING JOINTS: Glued Clamped

6 Asbestos-Cement

9 Other (specify below)

Welded ☒

7 Fiberglass

Threaded

Blank casing diameter 16 in. to 140 ft., Dia. in. to ft., Dia. in. to ft.Casing height above land surface 12 in., weight lbs./ft. (Wall thickness or gauge No. 236)

TYPE OF SCREEN OR PERFORATION MATERIAL:

☒ Steel 3 Stainless steel
2 Brass 4 Galvanized steel

5 Fiberglass

7 PVC

10 Asbestos-cement

6 Concrete tile

8 RMP (SR)

11 Other (specify)

9 ABS

12 None used (open hole)

SCREEN OR PERFORATION OPENINGS ARE:

1 Continuous slot 3 Mill slot
2 Louvered shutter 4 Key punched

5 Gauzed wrapped

☒ Saw cut

11 None (open hole)

☒ Wire wrapped

9 Drilled holes

7 Torch cut

10 Other (specify)

SCREEN-PERFORATED INTERVALS: From 140 ft. to 170 ft. From 170 ft. to 180 ft. From 180 ft. to 185 ft.GRAVEL PACK INTERVALS: From 140 ft. to 180 ft. From 180 ft. to 185 ft.

6 GROUT MATERIAL:

1 Neat cement

☒ Cement grout

3 Bentonite

4 Other

Grout Intervals: From 0 ft. to 20 ft. From ft. to ft. From ft. to ft.

What is the nearest source of possible contamination:

1 Septic tank 4 Lateral lines

7 Pit privy

10 Livestock pens

14 Abandoned water well

2 Sewer lines

5 Cess pool

8 Sewage lagoon

11 Fuel storage

15 Oil well/Gas well

3 Watertight sewer lines 6 Seepage pit

☒ Feedyard

12 Fertilizer storage

16 Other (specify below)

13 Insecticide storage

Direction from well?

How many feet? 500'

FROM	TO	LITHOLOGIC LOG	FROM	TO	PLUGGING INTERVALS
0	1	top soil			
1	50	brown clay & gypsum			
50	61	fine to medium sand			
61	70	medium to coarse sand, small gravel			
70	88	brown clay & gypsum			
88	94	fine sand			
94	102	brown clay & gypsum			
102	110	fine sand			
110	119	brown clay			
119	138	fine sand with clay streaks			
138	144	fine to medium sand			
144	152	fine sand with clay streaks			
152	170	fine to medium sand			
170	177	medium to coarse sand & gravel			
177	185	yellow clay			

7 CONTRACTOR'S OR LANDOWNER'S CERTIFICATION: This water well was ☒ constructed, (2) reconstructed, or (3) plugged under my jurisdiction and was completed on (mo/day/year) 9-25-92 and this record is true to the best of my knowledge and belief. KansasWater Well Contractor's License No. 532 This Water Well Record was completed on (mo/day/yr) 9-26-92under the business name of Midwest Well & Pump by (signature) Nick Spickup