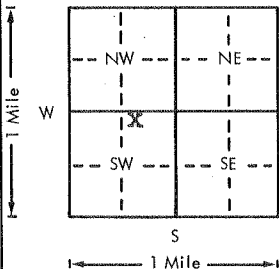
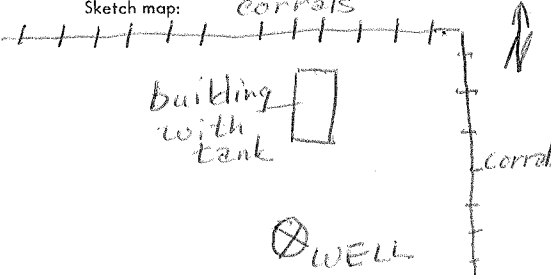


USE TYPEWRITER OR BALL  
POINT PEN-PRESS FIRMLY,  
PRINT CLEARLY.

WATER WELL RECORD  
KSA 82a-1201-1215

Kansas Department of Health and  
Environment-Division of Environment  
(Water well Contractors)  
Topeka, Kansas 66620

1. Location of well:		County <b>Scott</b>	Fraction <b>NW 1/4 NE 1/4 SW 1/4</b>	Section number <b>23</b>	Township number <b>T 17 S</b>	Range number <b>R 32 E</b>
2. Distance and direction from nearest town or city: <b>Scott City</b> <b>5 miles N, 4 1/2 Miles E, 1/2 mile N</b> Street address of well location if in city:			3. Owner of well: <b>Brookover cattle company</b> R.R. or street: <b>RFD 3</b> City, state, zip code: <b>Scott City, KS 67871</b>			
4. Locate with "X" in section below:		Sketch map:		6. Bore hole dia. <b>22</b> in. Completion date <b>32-3-20-78</b> Well depth <b>180</b> ft.		
				7. Cable tool <input checked="" type="checkbox"/> Rotary <input type="checkbox"/> Driven <input type="checkbox"/> Dug <input type="checkbox"/> Hollow rod <input type="checkbox"/> Jetted <input type="checkbox"/> Bored <input type="checkbox"/> Reverse rotary		
5. Type and color of material		From	To	8. Use: <input type="checkbox"/> Domestic <input type="checkbox"/> Public supply <input type="checkbox"/> Industry <input type="checkbox"/> Irrigation <input type="checkbox"/> Air conditioning <input checked="" type="checkbox"/> Stock <input type="checkbox"/> Lawn <input type="checkbox"/> Oil field water <input type="checkbox"/> Other		
Note: This is the log of the test holes that the well was drilled on				9. Casing: Material <input type="checkbox"/> Height: Above or below Threaded <input type="checkbox"/> Welded <input checked="" type="checkbox"/> Surface <b>30</b> in. RMP <input type="checkbox"/> PVC <input type="checkbox"/> Weight <input type="checkbox"/> lbs./ft. Dia. <b>12</b> in. to <b>140</b> ft. depth Wall Thickness: inches or Dia. <input type="checkbox"/> in. to <input type="checkbox"/> ft. depth gage No. <b>0.250</b>		
				10. Screen: Manufacturer's name <b>W. A. Brown</b> Type <b>punched metal</b> Dia. <b>12"</b> Slot/gauze <b>smallest made</b> Length <b>40 ft</b> Set between <b>140</b> ft. and <b>180</b> ft. ft. and <input type="checkbox"/> ft. Gravel pack? <input checked="" type="checkbox"/> yes Size range of material <b>1/16 down</b>		
Soil and dirt		0	20	11. Static water level: <input type="checkbox"/> mo./day/yr. <b>118</b> ft. below land surface Date <b>2-10-78</b>		
Sandy clay, some gyp		20	60	12. Pumping level below land surfaces: ft. after <input type="checkbox"/> hrs. pumping <input type="checkbox"/> g.p.m. ft. after <input type="checkbox"/> hrs. pumping <input type="checkbox"/> g.p.m. Estimated maximum yield <b>150</b> g.p.m.		
Coarse sand, clay streaks		60	95	13. Water sample submitted: <input type="checkbox"/> mo./day/yr. <input type="checkbox"/> Yes <input checked="" type="checkbox"/> No Date <input type="checkbox"/>		
Coarse sand, gyp streaks		95	105	14. Well head completion: <input checked="" type="checkbox"/> Pitless adapter <b>30</b> inches above grade		
Fine sand and clay		105	140	15. Well grouted? <input type="checkbox"/> With: <input checked="" type="checkbox"/> Neat cement <input type="checkbox"/> Bentonite <input type="checkbox"/> Concrete Depth: From <b>0</b> ft. to <b>20</b> ft.		
Fine sand		140	180	16. Nearest source of possible contamination: ft. <b>32</b> Direction <b>N &amp; E</b> Type <b>corrals</b> Well disinfected upon completion? <input checked="" type="checkbox"/> Yes <input type="checkbox"/> No		
Fine sand and clay		180	190	17. Pump: Manufacturer's name <b>Aermotor</b> Not installed Model number <input type="checkbox"/> HP <b>10</b> Volts <input type="checkbox"/> Length of drop pipe <b>168</b> ft. capacity <b>100</b> g.p.m. Type: <input checked="" type="checkbox"/> Submersible <input type="checkbox"/> Turbine <input type="checkbox"/> Jet <input type="checkbox"/> Reciprocating <input type="checkbox"/> Centrifugal <input type="checkbox"/> Other		
Yellow clay		190	196	20. Water well contractor's certification: This well was drilled under my jurisdiction and this report is true to the best of my knowledge and belief. <b>ABC Drilling, Inc.</b> <b>246</b> Business name License No. Address <b>Scott City, KS 67871</b> Signed <b>Sylvia H. Reno</b> Date <b>4-8-78</b> Authorized representative		
Blue shale		196				
18. Elevation:		19. Remarks:				
Topography: <input type="checkbox"/> Hill <input type="checkbox"/> Slope <input checked="" type="checkbox"/> Upland <input type="checkbox"/> Valley						

Forward the white, blue and pink copies to the Department of Health and Environment

Form WWC-5